

STATE OF MICHIGAN
DEPARTMENT
OF
NATURAL RESOURCES

LAND CORNER RECORD


CRAWFORD COUNTY
T 28 N R 4 W

DESCRIPTION OF CORNER S 1/16 on W Section line

CORNER MONUMENT Set 1"x24" pipe

DATE MONUMENT PLACED AND WITNESSED 5-31-72

WITNESSES TO CORNER.....

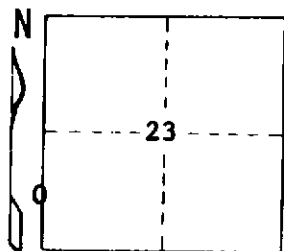

Nail in 6" W.Pine S 55 E 31.8'


Nail in Power Pole S 25 W 105.1'

AND

CIRCLE CORNER REGISTERED

DESCRIPTION IN DETAIL AS TO HOW CORNER WAS LOCATED AND IDENTIFIED OR RESTORED.

Corner set by standard procedure for the subdivision of sections; to mark state land boundary.

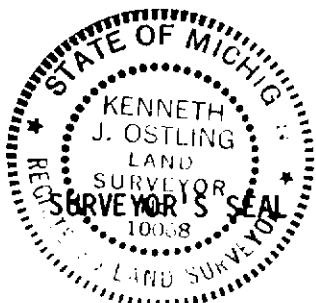

DISTRIBUTION:

Forestry Division, Lansing

SIGNED

Kenneth J. Ostling
REGISTERED LAND SURVEYOR 10068

DATE

5-31-72