


STATE OF MICHIGAN
DEPARTMENT
OF
NATURAL RESOURCES
LAND CORNER RECORD

CRAWFORD COUNTY
T 28 N R 4 W

DESCRIPTION OF CORNER E 1/4 - Sec. 23
CORNER MONUMENT Set DNR Monument
DATE MONUMENT PLACED AND WITNESSED 5-23-72
WITNESSES TO CORNER.....

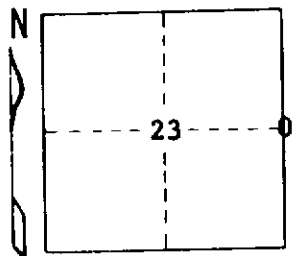


5" Maple in clmp. N 63 E 30.0'
8" Maple N 32 W 38.5'
AND

CIRCLE CORNER REGISTERED

DESCRIPTION IN DETAIL AS TO HOW CORNER WAS LOCATED AND IDENTIFIED OR RESTORED.

Set by single proportionate measurement between section corners. No evidence of a previous corner.

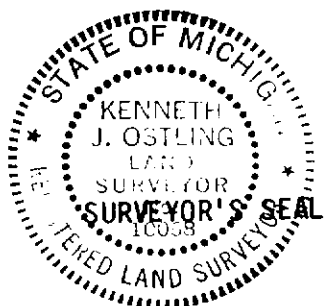

DISTRIBUTION:

Forestry Division, Lansing

SIGNED Kenneth J. Ostling DATE 5-30-72
REGISTERED LAND SURVEYOR 10068