

STATE OF MICHIGAN
DEPARTMENT
OF
NATURAL RESOURCES

LAND CORNER RECORD

CRAWFORD COUNTY


T 28 N R 4 W

DESCRIPTION OF CORNER NW Section Corner

CORNER MONUMENT Set Dept. Monument

DATE MONUMENT PLACED AND WITNESSED 5-23-72

WITNESSES TO CORNER.....

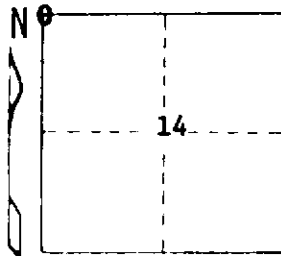

4" Maple S 27 W 14.6'


10" Bl. Cherry clmp S 76 E 7.2'

AND

CIRCLE CORNER REGISTERED

DESCRIPTION IN DETAIL AS TO HOW CORNER WAS LOCATED AND IDENTIFIED OR RESTORED.

This corner established in a 1954 survey in this area by this Department. Set by proportionate measurement between corners 1 mile West, 1 mile East, 2 miles North and 2 miles South. Corner was not monumented at that time and the random line intersection, about 80' North, was erroneously considered the corner by adjacent owners. Our position presents a more equitable distribution of the available lands, and closer conformity with the U.S. record.

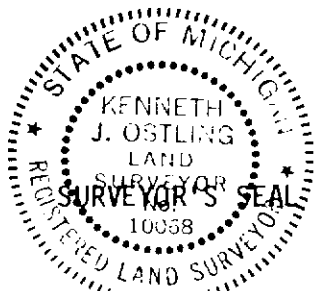

DISTRIBUTION:

SIGNED Kenneth J. Ostling DATE 5-25-72

REGISTERED LAND SURVEYOR

10068

County Courthouse
Area Forester (Regions I & II)
District or Region Surveyor
Forestry Div., Lansing

R 4047
Rev. 10/68