

STATE OF MICHIGAN
DEPARTMENT
OF
NATURAL RESOURCES

LAND CORNER RECORD


CRAWFORD COUNTY
T 28 N R 4 W

DESCRIPTION OF CORNER West 1/4 corner

CORNER MONUMENT Set Dept. Monument

DATE MONUMENT PLACED AND WITNESSED 5-24-72

WITNESSES TO CORNER..... 7" Bl. Cherry West 54.8'

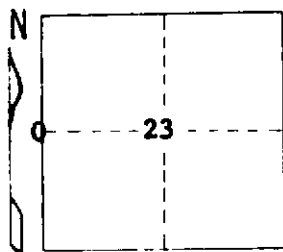

3" Maple N 08 W 12.7'


2" R. Pine N 62 E 45.95'

AND

CIRCLE CORNER REGISTERED

DESCRIPTION IN DETAIL AS TO HOW CORNER WAS LOCATED AND IDENTIFIED OR RESTORED.

This corner set by proportionate measurement between section corners. No evidence of a previous corner.

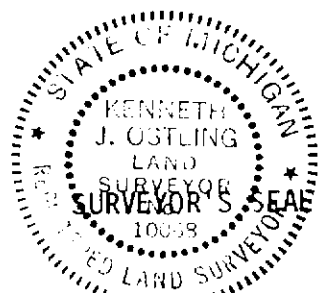

DISTRIBUTION:

SIGNED

Kenneth J. Ostling
REGISTERED LAND SURVEYOR
10068

DATE

5-25-72

County Courthouse
Area Forester (Regions I & II)
District or Region Surveyor
Forestry Div., Lansing

R 4047
Rev. 10/68