


STATE OF MICHIGAN  
DEPARTMENT  
OF  
NATURAL RESOURCES

## LAND CORNER RECORD

CRAWFORD COUNTY  
T 28 N R 4 W

DESCRIPTION OF CORNER NW Section Corner  
 CORNER MONUMENT Set Dept. Monument  
 DATE MONUMENT PLACED AND WITNESSED 5-24-72

WITNESSES TO CORNER..... 8" B. Cherry N 60 E 18.6'

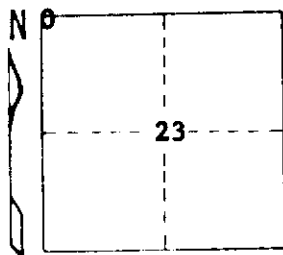

3" R. Pine N 50 E 42.4'

4" R. Pine S 72 E 33.7'


AND

CIRCLE CORNER REGISTERED

DESCRIPTION IN DETAIL AS TO HOW CORNER WAS LOCATED AND IDENTIFIED OR RESTORED.

Corner restored by double proportionate measurement between section corners 1 mile N,S,E and W. This results in a more equitable distribution of lands and fits U.S. record better.

No evidence of a previously established corner, although a squared post believed to be G.F. DeLaMater temporary corner was found about 45' Easterly of our position.

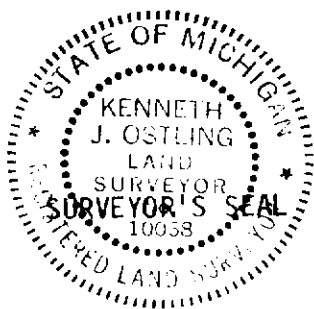

DISTRIBUTION:

SIGNED

*Kenneth J. Ostling*  
REGISTERED LAND SURVEYOR  
10068

DATE

5-25-72

County Courthouse  
Area Forester (Regions I & II)  
District or Region Surveyor  
Forestry Div., Lansing

R 4047  
Rev. 10/68