

LAND CORNER RECORDATION CERTIFICATE

FILING REQUIREMENT OF ACT 74, MICH. P.A.1970

| FOR CORNERS OF--: | LOCATED IN--: | CORNER CODE NUMBER |
|--|--|--------------------|
| 1. PUBLIC LAND SURVEY _____ | T. <u>28</u> N. <u>•</u> , R. <u>4</u> W. <u>•</u> | <u>F-13; G-13</u> |
| 2. PROPERTY CONTROLLING IN SECTION <u>33</u> | T. <u>28</u> N. <u>•</u> , R. <u>4</u> W. <u>•</u> | <u>16</u> |
| 3. MISCELLANEOUS PROPERTY IN SECTION _____ | T. _____ N. _____, R. _____ E. _____ W. _____ | _____ |
| 4. LOT NO. _____, RECORDED PLAT _____ | | |
| 5. PRIVATE CLAIMS _____ | | |

REGISTER OF DEEDS STAMP AND FILING NUMBER

I, Kenneth J. Ostling do hereby certify that under requirements of P.A. 74, Michigan P.A. of 1970, the corner points mentioned in lines 1 and 2 above (identified with circles on index code diagram - over) were, in a field survey on May 18, 1973, established, re-established, monumented, re-monumented, recovered or restored as expressed below and in conformance with regulations and rules therefore as required in the current manual of survey instructions of the United States Department of the Interior, Bureau of Land Management or by a decree of a court of law. Furthermore, that the corner points mentioned in lines 3, 4 and 5 above were, in a field survey on _____ 19____, found, recovered, restored, established or re-established as expressed below and in conformance with the rules of the Michigan State Board of Registration for Land Surveyors or, by a Decree of a Court of law:

A. Description of original monument and accessories and/or subsequent restoration:

B. Description of corner evidence found and/or method applied in restoring or re-establishing corner:


- F-13 Set midpoint on line between section corners, as previously established by Houghton.
- G-13 Found iron in $\frac{1}{2}$ of pavement, previously witnessed by Houghton.
- 16 Set by standard survey procedure for the subdivision of sections.

C. Description of monument for corner and accessories established to perpetuate locating the position of the corner:

| F-13 | G-13 | 16 |
|------------------------|-----------------------------|------------------------|
| DNR Monument | Boatspike over another iron | Small P.K. Nail |
| 10" W. Oak N09°E 19.2' | 23" Maple N55°E 57.2' | 13" Maple N25°W 66.0' |
| 7" R. Oak S78°E 5.75' | USGS Mon. N18°E 26.45' | 5" W. Pine S40°W 76.3' |
| | 13" Beech S28°E 73.9' | |

SIGNED BY Kenneth J. Ostling
 SURVEYOR'S MICHIGAN REGISTRATION NO. 10068

DATE 8/3/73

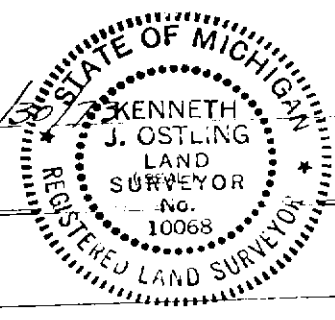

FOR STATE AND UNITED STATES AGENCIES:

SIGNED BY _____ CHIEF OF SURVEY PARTY DATE _____
 APPROVED AND SIGNED BY _____ MICHIGAN REGISTERED LAND SURVEYOR DATE _____ (SEAL)