

LAND CORNER RECORDATION CERTIFICATE

FILING REQUIREMENT OF ACT 74, MICH. P.A.1970

FOR CORNERS OF--:	LOCATED IN--:	CORNER CODE NUMBER
1. PUBLIC LAND SURVEY _____	T. <u>28</u> ^{N.} <u>●</u> , R. <u>4</u> ^{W.} <u>●</u>	F-9; F-11; G-10; G-11
2. PROPERTY CONTROLLING IN SECTION _____	, T. _____ ^{N.} S., R. _____ ^{E.} W.	_____
3. MISCELLANEOUS PROPERTY IN SECTION _____	, T. _____ ^{N.} S., R. _____ ^{E.} W.	_____
4. LOT NO. _____, RECORDED PLAT _____		
5. PRIVATE CLAIMS _____		

REGISTER OF DEEDS STAMP AND FILING NUMBER

I, Kenneth J. Ostling do hereby certify that under requirements of P.A. 74, Michigan P.A. of 1970, the corner points mentioned in lines 1 and 2 above (identified with circles on index code diagram - over) were, in a field survey on November 6, 1973, established, re-established, monumented, re-monumented, recovered or restored as expressed below and in conformance with regulations and rules therefore as required in the current manual of survey instructions of the United States Department of the Interior, Bureau of Land Management or by a decree of a court of law. Furthermore, that the corner points mentioned in lines 3, 4 and 5 above were, in a field survey on _____ 19____, found, recovered, restored, established or re-established as expressed below and in conformance with the rules of the Michigan State Board of Registration for Land Surveyors or, by a Decree of a Court of law:

A. Description of original monument and accessories and/or subsequent restoration:


B. Description of corner evidence found and/or method applied in restoring or re-establishing corner:

- F-9 Found 2" x 2" wood stake, 33.0 feet south of concrete-filled tile, as established in early county survey.
- F-11 Set corner by proportionate measurement between section corners. No other evidence.
- G-10 Found 1/4" pipe as established in previous local survey.
- G-11 Corner set by double proportionate measurement. A 1" pipe is about 40 feet southeast but could not justify this location when related to other corners.

C. Description of monument for corner and accessories established to perpetuate locating the position of the corner:

F-9	F-11	G-10
Set DNR Monument	Set DNR Monument	Set DNR Monument
Conc. filled tile N 33.0'	16" W. Pine S20W 132.9'	8" Y. Birch N27E 34.7'
13" Maple S17E 26.6'	4" Bl. Cherry S20E 12.5'	14" Bl. Cherry S38E 31.5'
14" Maple S66W 57.7'		
1/2" sq. iron S 32.8'	G-11	
	Set DNR Monument	
	10" Maple N56W 41.8'	
	7" Maple N67E 37.2'	

SIGNED BY Kenneth J. Ostling DATE 11/30/73
 SURVEYOR'S MICHIGAN REGISTRATION NO. 10068

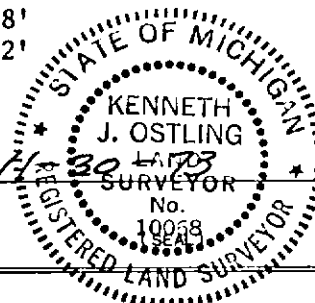

FOR STATE AND UNITED STATES AGENCIES:

SIGNED BY _____ DATE _____
CHIEF OF SURVEY PARTY

APPROVED AND SIGNED BY _____ DATE _____
MICHIGAN REGISTERED LAND SURVEYOR (SEAL)

SURVEYOR'S MICHIGAN REGISTRATION NO. _____