

LAND CORNER RECORDATION CERTIFICATE

FILING REQUIREMENT OF ACT 74, MICH. P.A.1970

FOR CORNERS OF--	LOCATED IN--	CORNER CODE NUMBER
1. PUBLIC LAND SURVEY _____	T. 28 N. R. 4 W.	D-11; E-9; F-7
2. PROPERTY CONTROLLING IN SECTION <u>16</u>	T. 28 N. R. 4 W.	16
3. MISCELLANEOUS PROPERTY IN SECTION _____	T. _____ N. S. R. _____ E. W.	_____
4. LOT NO. _____, RECORDED PLAT _____		
5. PRIVATE CLAIMS _____		

REGISTER OF DEEDS STAMP AND FILING NUMBER

I, Kenneth J. Ostling do hereby certify that under requirements of P.A. 74, Michigan P.A. of 1970, the corner points mentioned in lines 1 and 2 above (identified with circles on index code diagram - over) were, in a field survey on November 29, 1973, established, re-established, monumented, re-monumented, recovered or restored as expressed below and in conformance with regulations and rules therefore as required in the current manual of survey instructions of the United States Department of the Interior, Bureau of Land Management or by a decree of a court of law. Furthermore, that the corner points mentioned in lines 3, 4 and 5 above were, in a field survey on _____ 19____, found, recovered, restored, established or re-established as expressed below and in conformance with the rules of the Michigan State Board of Registration for Land Surveyors or, by a Decree of a Court of law:

A. Description of original monument and accessories and/or subsequent restoration:

B. Description of corner evidence found and/or method applied in restoring or re-establishing corner:

- D-11 Set corner by proportionate measurement between section corners. No U.S. evidence.
- E-9 Restored this corner according to the record of previous surveys. Falls on average line over corners east and west and fits measurements in both directions.
- F-7 Set corner by proportionate measurement between section corners. No U.S. evidence.
- 16 Set by standard survey procedure. Falls in line with parts of old fence line north.

C. Description of monument for corner and accessories established to perpetuate locating the position of the corner:

D-11	E-9	F-7
DNR Mon. & red top post	DNR Mon.	Set DNR Monument
8" Maple (in clump) N44E 31.0'	8" Beech S25W 30.2'	5" H. Maple S22W 9.5'
36" W.P. Stub S58W 35.4'	6" Maple N39W 49.9'	6" H. Maple N86W 28.0'
13" W.P. Stp. N30W 6.0'	About 8' S. of $\frac{1}{2}$ OF E-W Rd.	
16		
2½' of 1" pipe & red top post		
7" H. Maple N33E 1.1'		
7" H. Maple S55E 27.2'		


SIGNED BY Kenneth J. Ostling DATE 3/1/74

SURVEYOR'S MICHIGAN REGISTRATION NO. 10068

FOR STATE AND UNITED STATES AGENCIES:

SIGNED BY _____ DATE _____
CHIEF OF SURVEY PARTY

APPROVED AND SIGNED BY _____ DATE _____
MICHIGAN REGISTERED LAND SURVEYOR

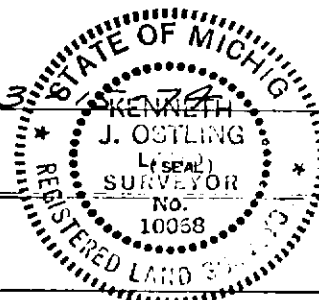

(SEAL)

SURVEYOR'S MICHIGAN REGISTRATION NO. _____