

# LAND CORNER RECORDATION CERTIFICATE

## FILING REQUIREMENT OF ACT 74, MICH. P.A. 1970

FOR CORNERS OF--	LOCATED IN--	CORNER CODE NUMBER
1. PUBLIC LAND SURVEY _____	T. 28 N. R. 4 W.	E-10; H-11
2. PROPERTY CONTROLLING IN SECTION <u>28</u>	T. 28 N. R. 4 W.	8;9
3. MISCELLANEOUS PROPERTY IN SECTION _____	T. _____ S. R. _____ E. W.	_____
4. LOT NO. _____, RECORDED PLAT _____		
5. PRIVATE CLAIMS _____		

REGISTER OF DEEDS STAMP AND FILING NUMBER

I, Kenneth J. Ostling do hereby certify that under requirements of P.A. 74, Michigan P.A. of 1970, the corner points mentioned in lines 1 and 2 above (identified with circles on index code diagram - over) were, in a field survey on December 26 1973, established, re-established, monumented, re-monumented, recovered or restored as expressed below and in conformance with regulations and rules therefore as required in the current manual of survey instructions of the United States Department of the Interior, Bureau of Land Management or by a decree of a court of law. Furthermore, that the corner points mentioned in lines 3, 4 and 5 above were, in a field survey on \_\_\_\_\_ 19\_\_\_\_, found, recovered, restored, established or re-established as expressed below and in conformance with the rules of the Michigan State Board of Registration for Land Surveyors or, by a Decree of a Court of law:

**A. Description of original monument and accessories and/or subsequent restoration:**

**B. Description of corner evidence found and/or method applied in restoring or re-establishing corner:**

- F-10 Set at calculated intersection of true  $\frac{1}{4}$  lines.
- H-11 Found conc. tile monument as established in early county survey.
- 8 Set by standard survey procedure.
- 9 Set by standard survey procedure.

**C. Description of monument for corner and accessories established to perpetuate locating the position of the corner:**


F-10	H-11	8
2½" of 1" pipe	½" rod in conc. filled tile	2½" of 1" pipe
6" Maple S49E 10.2	9" Maple N38W 25.7'	8" Maple S70E 12.5'
16" Maple S12E 23.4'	7" Maple S63W 23.1	6" Maple S45W 22.8

9

2½" of 1" pipe	
7" Maple N53W	31.4
17" Hemlock S74E	80.4

SIGNED BY Kenneth J. Ostling DATE March 12, 1974

SURVEYOR'S MICHIGAN REGISTRATION NO. 10068

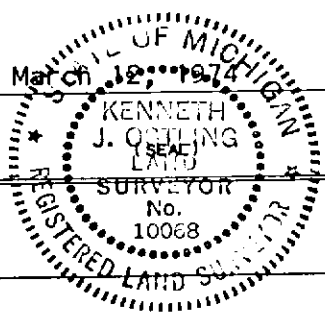

FOR STATE AND UNITED STATES AGENCIES:

SIGNED BY \_\_\_\_\_ DATE \_\_\_\_\_  
CHIEF OF SURVEY PARTY

APPROVED AND SIGNED BY \_\_\_\_\_ DATE \_\_\_\_\_  
MICHIGAN REGISTERED LAND SURVEYOR

(SEAL)

SURVEYOR'S MICHIGAN REGISTRATION NO. \_\_\_\_\_