

# LAND CORNER RECORDATION CERTIFICATE

## FILING REQUIREMENT OF ACT 74, MICH. P.A.1970

FOR CORNERS OF—:	LOCATED IN—:	CORNER CODE NUMBER
1. PUBLIC LAND SURVEY _____	T. 28 <sup>N.</sup> <sub>○</sub> , R. 4 <sub>○</sub> <sup>W.</sup>	L-1; M-1
2. PROPERTY CONTROLLING IN SECTION <u>2</u>	, T. 28 <sup>N.</sup> <sub>○</sub> , R. 4 <sub>○</sub> <sup>W.</sup>	2
3. MISCELLANEOUS PROPERTY IN SECTION _____	, T. _____ <sup>N.</sup> <sub>○</sub> , R. _____ <sub>○</sub> <sup>E.</sup> <sub>○</sub> <sup>W.</sup>	
4. LOT NO. _____	, RECORDED PLAT _____	
5. PRIVATE CLAIMS _____		

*Crawford*

REGISTER OF DEEDS STAMP AND FILING NUMBER

I, Kenneth J. Ostling do hereby certify that under requirements of P.A. 74, Michigan P.A. of 1970, the corner points mentioned in lines 1 and 2 above (identified with circles on index code diagram—over) were, in a field survey on June 21, 1974, established, re-established, monumented, re-monumented, recovered or restored as expressed below and in conformance with regulations and rules therefore as required in the current manual of survey instructions of the United States Department of the Interior, Bureau of Land Management or by a decree of a court of law. Furthermore, that the corner points mentioned in lines 3, 4 and 5 above were, in a field survey on \_\_\_\_\_ 19\_\_\_\_, found, recovered, restored, established or re-established as expressed below and in conformance with the rules of the Michigan State Board of Registration for Land Surveyors or, by a Decree of a Court of law:

A. Description of original monument and accessories and/or subsequent restoration:

B. Description of corner evidence found and/or method applied in restoring or re-establishing corner:

- L-1 Set by proportionate measurement between section corners.
- M-1 Corner set by proportionate measurement between corners ½ mile east, ½ mile south, 1 mile north and west. Our position falls 170'± NW of a ½" bar set at the end of a random line between 6 and 31 which is felt was not properly researched. Government measure can be nearly fulfilled between the controlling corners and we could not justify a departure from the prescribed method of lost corner restoration.
- 2 Set by standard survey procedure for the subdivision of sections.


C. Description of monument for corner and accessories established to perpetuate locating the position of the corner:

L-1			M-1			2		
DNR monument & red-top post			DNR monument & red-top post			2½' of 3/4" pipe & red-top post		
7" Twn. Beech	N07°W	28.9	42" W.P. stub	S20°W	67.6	8" R. Pine	N32°E	37.5
6" Beech	S77°E	22.7	6" Maple	N19°W	23.5	6" R. Pine	N07°W	40.6
9" Maple	N48°E	27.5	4" Maple	N49°E	10.0	5" R. Pine (no marks)		
							S56°E	14.1
						3" R. Pine (no marks)		
							N77°E	33.2

SIGNED BY Kenneth J. Ostling

DATE 7-17-74

SURVEYOR'S MICHIGAN REGISTRATION NO. 10068

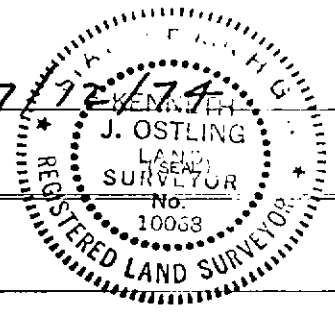

FOR STATE AND UNITED STATES AGENCIES:

SIGNED BY \_\_\_\_\_ DATE \_\_\_\_\_  
CHIEF OF SURVEY PARTY

APPROVED AND SIGNED BY \_\_\_\_\_ DATE \_\_\_\_\_  
MICHIGAN REGISTERED LAND SURVEYOR

(SEAL)

SURVEYOR'S MICHIGAN REGISTRATION NO. \_\_\_\_\_

CRAWFORD COUNTY