

LAND CORNER RECORDATION CERTIFICATE

FILING REQUIREMENT OF ACT 74, MICH. P.A.1970

CRAWFORD

FOR CORNERS OF--:	LOCATED IN--:	CORNER CODE NUMBER
1. PUBLIC LAND SURVEY _____	T. 28 N. R. 4W	G-3; G-4; H-9
2. PROPERTY CONTROLLING IN SECTION <u>27</u>	T. 28 N. R. 4	1
3. MISCELLANEOUS PROPERTY IN SECTION _____	T. _____ N. R. _____	
4. LOT NO. _____, RECORDED PLAT _____		
5. PRIVATE CLAIMS _____		

REGISTER OF DEEDS STAMP AND FILING NUMBER

I, Kenneth J. Ostling do hereby certify that under requirements of P.A. 74, Michigan P.A. of 1970, the corner points mentioned in lines 1 and 2 above (identified with circles on index code diagram—over) were, in a field survey on March 18 1974, established, re-established, monumented, re-monumented, recovered or restored as expressed below and in conformance with regulations and rules therefore as required in the current manual of survey instructions of the United States Department of the Interior, Bureau of Land Management or by a decree of a court of law. Furthermore, that the corner points mentioned in lines 3, 4 and 5 above were, in a field survey on _____ 19____, found, recovered, restored, established or re-established as expressed below and in conformance with the rules of the Michigan State Board of Registration for Land Surveyors or, by a Decree of a Court of law:

A. Description of original monument and accessories and/or subsequent restoration:

B. Description of corner evidence found and/or method applied in restoring or re-establishing corner:

- G-3 Set by double proportionate measurement during a retracement in this township.
- G-4 Set by proportionate measurement to the U.S. survey.
- H-9 Set by proportionate measurement between section corners.
- 1 Set by standard survey procedure for the subdivision of sections.

C. Description of monument for corner and accessories established to perpetuate locating the position of the corner:

G-3	G-4	H-9
DNR Mon	DNR Mon.	DNR Mon. & Red Top Post
5" Maple S83W 33.9'	3" Maple S32W 12.25'	6" Poplar N80W 11.6'
3" Elm S47W 12.0'	8" Birch N30W 19.6'	Tw. 3" Maples S58W 11.9'
2" Elm North 13.1		1" W. Pine N59E 27.9'
	1	
	2½' of 1" Pipe & Red Top Post	
	8" Tw. Beech N70E 21.3'	
	7" Beech N5 E 18.1'	


SIGNED BY *Kenneth J. Ostling* DATE 4/25/74

SURVEYOR'S MICHIGAN REGISTRATION NO. 10068

FOR STATE AND UNITED STATES AGENCIES:

SIGNED BY _____ DATE _____
CHIEF OF SURVEY PARTY

APPROVED AND SIGNED BY _____ DATE _____
MICHIGAN REGISTERED LAND SURVEYOR

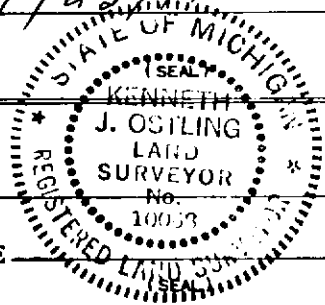

SURVEYOR'S MICHIGAN REGISTRATION NO. _____

CRAWFORD