

# LAND CORNER RECORDATION CERTIFICATE

## FILING REQUIREMENT OF ACT 74, MICH. P.A.1970

| FOR CORNERS OF --:  | LOCATED IN --:                          | CORNER CODE NUMBER |
|---|---|--------------------|
| 1. PUBLIC LAND SURVEY _____ T. _____  | N. _____ S., R. _____ E. _____ W. _____ | _____              |
| 2. PROPERTY CONTROLLING IN SECTION <u>16</u> , T. <u>28</u> N. _____ R. <u>4</u> W. _____ | _____                                   | <u>12; 13</u>      |
| 3. MISCELLANEOUS PROPERTY IN SECTION _____ T. _____                                       | N. _____ S., R. _____ E. _____ W. _____ | _____              |
| 4. LOT NO. _____ , RECORDED PLAT _____  |   |                    |
| 5. PRIVATE CLAIMS _____   |   |                    |

REGISTER OF DEEDS STAMP AND FILING NUMBER

I, Kenneth J. Ostling, do hereby certify that under requirements of P.A. 74, Michigan P.A. of 1970, the corner points mentioned in lines 1 and 2 above were, in a field survey on April 18, 1978, established, re-established, monumented, re-monumented, recovered or restored as expressed below and in conformance with regulations and rules therefore as required in the current manual of survey instructions of the United States Department of the Interior, Bureau of Land Management or by a decree of a court of law. Furthermore, that the corner points mentioned in lines 3, 4 and 5 above were, in a field survey on \_\_\_\_\_, 19\_\_\_\_, found, recovered, restored, established or re-established as expressed below and in conformance with the rules of the Michigan State Board of Registration for Land Surveyors or, by a Decree of a Court of law:

A. Description of original monument and accessories and/or subsequent restoration:

B. Description of corner evidence found and/or method applied in restoring or re-establishing corner:

12 Set by standard survey procedure for the subdivision of sections.


13 Set by standard survey procedure for the subdivision of sections.

C. Description of monument for corner and accessories established to perpetuate locating the position of the corner:

12  
5/8" x 36" Bar w/Cap  
9" H. Maple N34°E 9.3  
10" H. Maple N70°W 34.1

13  
5/8" x 36" Iron Bar w/Cap  
12" W. Birch S83°W 233.75  
6" Twn.W.Birch N25°W 246.3

SIGNED BY *Kenneth J. Ostling* DATE 8/24/78  
SURVEYOR'S MICHIGAN REGISTRATION NO. 10068

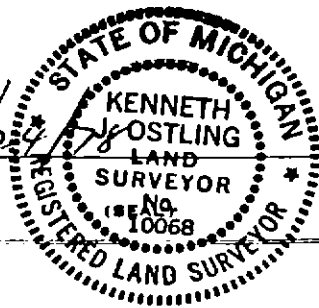

FOR STATE AND UNITED STATES AGENCIES.

SIGNED BY \_\_\_\_\_ DATE \_\_\_\_\_  
CHIEF OF SURVEY PARTY  
APPROVED AND SIGNED BY \_\_\_\_\_ DATE \_\_\_\_\_  
MICHIGAN REGISTERED LAND SURVEYOR

SURVEYOR'S MICHIGAN REGISTRATION NO. \_\_\_\_\_ CRAWFORD COUNTY

MAY PLACE SKETCH ON BACK OR ATTACHED SHEET