

MICHIGAN
DEPARTMENT OF CONSERVATION
FORESTRY DIVISION

LAND CORNER RECORD


T. 32 N.R. 3 W.
T. 32 N.R. 4 W. Charlevoix COUNTY

DESCRIPTION OF CORNER Section corner common to Sections 7 - 18 - 12 - 13

CORNER MONUMENT Left 1/2" iron bar in place below surface

DATE MONUMENT PLACED AND WITNESSED May 16, 1962

WITNESSES TO CORNER.....

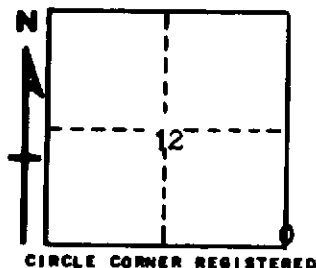

12" Hemlock N 40 W 75.9'

10" H. Maple S 49 W 43.2'

AND

CIRCLE CORNER REGISTERED

DESCRIPTION IN DETAIL AS TO HOW CORNER WAS LOCATED AND IDENTIFIED OR RESTORED.

This corner was found while making a survey in this area. Found 1/2" iron bar at corner apparently as established by G. F. De La Mater, whose NBTs are in place but stumps are rotting. Falls in center of N - S county line road, in line with trail east. Considered acceptable, no evidence to the contrary.

SURVEYOR'S SEAL

SIGNED Kenneth J. Ostling DATE May 16, 1962
REGISTERED LAND SURVEYOR