

MICHIGAN  
DEPARTMENT OF CONSERVATION  
FORESTRY DIVISION

# LAND CORNER RECORD

T. 32 N.R. 4 W.


Charlevoix COUNTY

DESCRIPTION OF CORNER Section corner common to Sections 11 - 12 - 13 - 14

CORNER MONUMENT Set 1" pipe with 4" brass cap

DATE MONUMENT PLACED AND WITNESSED May 15, 1962

WITNESSES TO CORNER.....

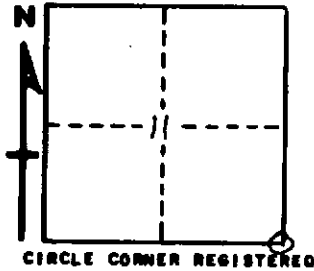

8" H. Maple N 35 E 11.4'

6" H. Maple N 63 W 19.4'

AND

8" H. Maple S 67 E 8.7'

**DESCRIPTION IN DETAIL AS TO HOW CORNER WAS LOCATED AND IDENTIFIED OR RESTORED.**

This corner was found while making a survey in this area. Recovered corner as established by Robinson in early 1900s, probably before 1910. Found very good stake point at corner, with remains of both Robinson NBTs of record in place, a large Hemlock stump NW and remains of Beech stump SW. Recovered part of the notch from the Beech. Checks very well by proportionate measurement for longitude. Probably a restoration of the government corner.

**SURVEYOR'S SEAL**

SIGNED

*Kenneth J. Ostling*  
REGISTERED LAND SURVEYOR

DATE

May 17, 1962