

MICHIGAN  
DEPARTMENT OF CONSERVATION  
FORESTRY DIVISION

# LAND CORNER RECORD

T. 32 N.R. 4 W.


Charlevoix COUNTY

DESCRIPTION OF CORNER Section corner common to Sections 10 - 11 - 14 - 15

CORNER MONUMENT Set 1" pipe with 4" brass cap

DATE MONUMENT PLACED AND WITNESSED May 15, 1962

WITNESSES TO CORNER.....

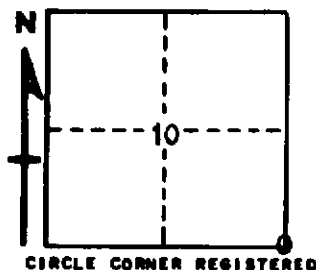

10" H. Maple N 59 E 14.0'

7" H. Maple S 8 E 51.2'

AND

8" Elm N 41 W 21.0

**DESCRIPTION IN DETAIL AS TO HOW CORNER WAS LOCATED AND IDENTIFIED OR RESTORED.**

This corner was found while making a survey in this area. Found definite evidence of very old stake point (a dark stain, properly shaped) at corner. Remains of the probable U. S. witness tree stumps in place, at record bearing and distance. Checks very well for distance to good corners in all directions, considering proportionate measurement. Falls in old logging road in deep valley. Sufficient support for consideration as government corner.

**SURVEYOR'S SEAL**

SIGNED

*Kenneth J. Bething*  
REGISTERED LAND SURVEYOR

DATE

May 17, 1962