LAND CORNER RECORDATION CERTIFICATE

Filing Requirement of Act 74, Mich. P.A. 1970

For corners in CHARLEVOIX (County)

	Located in:	Corner Code ##
1. Public Land Survey	T 32N R 4W	E-2, E-3
	T ___ R ___	
	T ___ R ___	
	T ___ R ___	
2. Property Controlling	S ___ T ___ R ___	
In Section	S ___ T ___ R ___	
3. Miscellaneous	S ___ T ___ R ___	
Property in Sec.	S ___ T ___ R ___	

Register of Deeds Stamp & File Number

4. Lot No. _____ , Recorded Plat _____
5. Private Claims _____

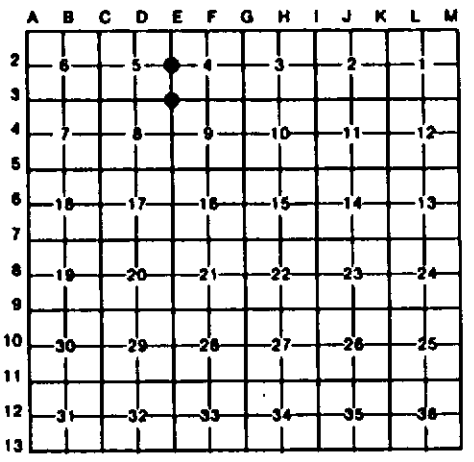

I, C.F.ROSER , in a field survey on APRIL, 6 , 19 95 , do hereby certify that under requirements of P.A. 74, Michigan P.A. of 1970, the corner points mentioned in lines 1 and 2 above were in conformance with regulations and rules therefore as required in the current manual of survey instructions of the United States Department of the Interior, Bureau of Land Management or by a decree of a Court of Law and/or that the corner points mentioned in lines 3, 4 and 5 above were in conformance with the rules of the Michigan Board of Land Surveyors or by a Decree of a Court of Law; established, re-established, monumented, re-monumented, recovered, found as expressed below:

NOTE: Not more than 4 corners, all in the same town and range, may be recorded on this certificate.

A. Description of original monument and accessories and/or subsequent restoration:

E-2

(NO EVIDENCE OF G.L.O. CORNER, B.T'S, LINE TREES & TOPOGRAPHY, AS CALLED OUT IN THE G.L.O. LINE NOTES; UNLESS NOTED IN ITEM "B" BELOW.)

E-3

E-3 CONT.

B. Description of corner evidence found and/or method applied in restoring or reestablishing corner:

E-2

ESTABLISHED W1/4 COR OF SEC. 4 PRORATED DIST. TO US GLO RUN-OUT. CTR. OF N-S WINDING B.TOP ROAD IS 266'± WEST.

E-3

FOUND CONC. MON. FOR SW COR. OF SEC. 4. K.J.OSTLING FD R.R. IRON IN 1966 DEPT. SURVEY AS CALLED FOR BY E.A.ROBINSON IN 1904 NOTE (SEE OLD SURVEY NOTES FOR HUDSON TWP, T32N-R4W, BOOK 6, PG. 38. EAR SAID "SET PIECE OF RR STEEL 36" LONG"). BY COMPARISION OF K.J.O'S. AND OUR TIES TO FD. CONC MON & TWO FD 2" PIPES (1 MI & 2 MILES NORTH, PIPE'S ARE

E-3 CONT.

BY M.SCHAAF BUT WERE NOT ACCEPTED AS FINAL THIS SURVEY), THE CONC MON MUST BE AT POSITION OF RR IRON BY E.A.ROBINSON.
K.J.O. DID NOT RECORD FD RR IRON IN 1966. CENTER OF B.TOP RD.(NW-SE) IS N75°E, 13.5'.

C. Description of monument for corner and accessories established to perpetuate locating the position of the corner:

E-2

SET DNR MON & CEDAR POST.

4" IRONWOOD	N64°E	19.1'
13" MAPLE	S58°E	61.0'
5" OAK	S34°W	26.0'
7" TW.MAPLE	N26°W	37.1'

E-3

FOUND ROUND CONC. MON.

12" MAPLE	N78°W	45.03'
7" MAPLE	N44°E	66.20'
P.POLE	S16°W	40.71'

FD. ROUND CONC. MON. AT FN. COR (FN W. & ROW FN SE & NW) IS N89°41'W 36.14'
SET CEDAR POST WITH LOC. TAG WEST 36'

E-3 CONT.

STATE OF MICHIGAN
CARL F. ROSER
LAND SURVEYOR
No. 12028
REGISTERED LAND SURVEYOR

Signed by Carl F. Roser Date 6-08-95

Surveyor's Michigan License No. 12028

FORM APPROVED BY MICHIGAN STATE BOARD OF LAND SURVEYORS, JAN. 28, 1971
REVISED MAY 14, 1975
REVISED JAN., 1983