

REMONUMENTATION
 APR 06 1995
 COMMISSION

2-311

CHARLEVOIX COUNTY REMONUMENTATION
LAND CORNER RECORDATION CERTIFICATE
 Filing Requirement of Act 74, Mich. P.A. 1970
 ALSO ACT 345, PA 1990

STATE OF MICHIGAN
 COUNTY OF CHARLEVOIX
 RECEIVED FOR RECORD

1994 DEC 22 PM 1:53

Charlene M. Probst
 REGISTER OF DEEDS


For corners in

CHARLEVOIX (County)	Located In:	Corner Code #
1. Public Land Survey	T 32N R R4W	A-3
	T _____ R _____	_____
	T _____ R _____	_____
	T _____ R _____	_____
2. Property Controlling in Section	S _____ T _____ R _____	_____
	S _____ T _____ R _____	_____
3. Miscellaneous Property in Sec.	S _____ T _____ R _____	_____
	S _____ T _____ R _____	_____

Register of Deeds Stamp & File Number

4. Lot No. _____, Recorded Plat _____
 5. Private Claims _____

I, Wayne E. Boss, in a field survey on September 27, 19 94, do hereby certify that under requirements of P.A. 74, Michigan P.A. of 1970, the corner points mentioned in lines 1 and 2 above were in conformance with regulations and rules therefore as required in the current manual of survey instructions of the United States Department of the Interior, Bureau of Land Management or by a decree of a Court of Law and/or that the corner points mentioned in lines 3, 4 and 5 above were in conformance with the rules of the Michigan Board of Land Surveyors or by a Decree of a Court of Law; established, re-established, monumented, re-monumented, recovered, found as expressed below:

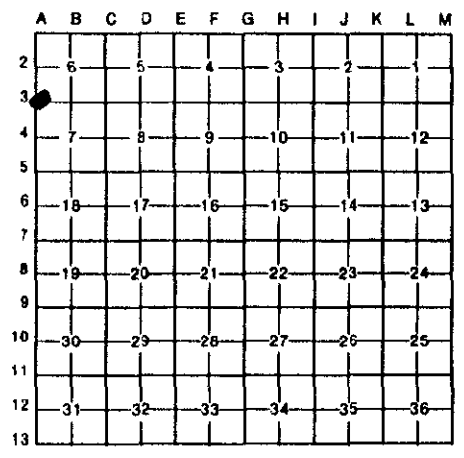

NOTE: Not more than 4 corners, all in the same town and range, may be recorded on this certificate.

A. Description of original monument and accessories and/or subsequent restoration:

Set Post corner Section 1 & 12,
 (T32N-R5W also common corner
 to Sec. 6 & 7, T32N-R4W)
 1. Beech 12" N06°E 30
 2. Beech 12" S31°W 19
 John Mullett May 1840

Fd. Sec. corner Post
 1. Beech 10" N08°E 30
 2. Beech 18" S42°E 49
 E. A. Robinson 1898, 1902

Set 1/2" rod and cap
 Witnesses:
 12" Maple N35°E 17.75'
 7" Ash N85°E 11.15'
 7" Ash S85°W 3.83'
 7" Ash S07°E 19.36'
 John E. Ferguson 1988

B. Description of corner evidence found and/or method applied in restoring or reestablishing corner:

Found no evidence of G.L.O. witnesses
 or subsequent restoration.
 Found 1/2" rod and cap set by double
 proration based on NE, S 1/4 corners, Section 1,
 SE of Section 12 and SE of Section 6, Hudson,
 according to corner recital as recorded in
 L 2, Page 236.

G.L.O. to A-2, 2640 meas. 2641.03'
 G.L.O. to A-4, 2640 meas. 2635.11'

C. Description of monument for corner and accessories established to perpetuate locating the position of the corner:

A-3 Charlevoix County Mon. set replacing 1/2" rod and cap.
 1. Spk. in Face 12" Maple N35°E 17.75'
 2. Spk. in Face 7" Basswood N85°E 11.15'
 3. Spk. in Face 7" Basswood S85°W 3.83'
 4. Spk. in Face 7" Basswood S07°E 19.36'
 And is accepted as a careful and faithful reestablishment of the position of the original corner.

Charlevoix Co. Surveyor
APPROVED
 Signature May C. Fennell
 Date: Dec. 16, 1994
 PA 345 of 1990

Signed by *Wayne E. Boss* Date December 14, 1994
 Surveyor's Michigan License No. 20703

