

REMICAN IMPROVEMENT
 APR 06 1995
 COMMISSION

2-312

STATE OF MICHIGAN
 COUNTY OF CHARLEVOIX
 RECEIVED FOR RECORD

1994 DEC 22 PM 1:54

CHARLEVOIX COUNTY REMONUMENTATION

LAND CORNER RECORDATION CERTIFICATE

Filing Requirement of Act 74, Mich. P.A. 1970
 ALSO ACT 345, PA 1990

Charlene B. Casler
 REGISTER OF DEEDS

For corners in _____
 CHARLEVOIX (County)

Located In:	Corner Code #
1. Public Land Survey T 32N R 4W	A-4
T _____ R _____	_____
T _____ R _____	_____
T _____ R _____	_____
2. Property Controlling S _____ T _____ R _____	_____
in Section S _____ T _____ R _____	_____
3. Miscellaneous S _____ T _____ R _____	_____
Property in Sec. S _____ T _____ R _____	_____
4. Lot No. _____, Recorded Plat _____	_____
5. Private Claims _____	_____

Register of Deeds Stamp & File Number

I, Wayne E. Boss, in a field survey on September 27, 1994, do hereby certify that under requirements of P.A. 74, Michigan P.A. of 1970, the corner points mentioned in lines 1 and 2 above were in conformance with regulations and rules therefore as required in the current manual of survey instructions of the United States Department of the Interior, Bureau of Land Management or by a decree of a Court of Law and/or that the corner points mentioned in lines 3, 4 and 5 above were in conformance with the rules of the Michigan Board of Land Surveyors or by a Decree of a Court of Law; established, re-established, monumented, re-monumented, recovered, found as expressed below:

	A	B	C	D	E	F	G	H	I	J	K	L	M
2	6	5	4	3	2	1							
3													
4	7	8	9	10	11	12							
5													
6	18	17	16	15	14	13							
7													
8	19	20	21	22	23	24							
9													
10	30	29	28	27	26	25							
11													
12	31	32	33	34	35	36							
13													

NOTE: Not more than 4 corners, all in the same town and range, may be recorded on this certificate.

A. Description of original monument and accessories and/or subsequent restoration:

- | | |
|--------------------------|----------------------------|
| Set qr. Section Post | Fd. Post and Old witness |
| 1. Beech 20" N11°E 52' | E. A. Robinson 1902 |
| 2. Hemlock 30" S07°W 17' | Re-witness: |
| John Mullett May 1840 | 1. Hemlock 20" S53°W 6' |
| | 2. Hemlock 40" N30½°W 20½' |


B. Description of corner evidence found and/or method applied in restoring or reestablishing corner:

Fence corner fd. Fence East and fence South bearing and distance to A-3 is N00°17'17"W, 2635.11'; bearing and distance to A-5 is S00°48'21"E, 2647.58'

C. Description of monument for corner and accessories established to perpetuate locating the position of the corner:

- A-4 Charlevoix County Mon. set at fence corner.
- Set Spk. 8" Maple N08°W 3.82'
 - Set Spk. 4" Maple N42°W 5.96'
 - Set Spk. 10" Basswood N80°W 23.45'
 - Set Spk. Fence Post S45°E 0.51'
- And is accepted as the best available evidence of the position of the original corner.

Charlevoix Co. Surveyor
 APPROVED
 Signature Wayne E. Boss
 Date: Dec 16, 1994

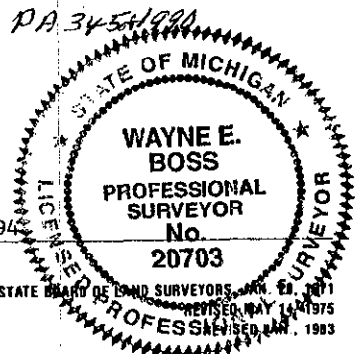

Signed by Wayne E. Boss Date December 14, 1994
 Surveyor's Michigan License No. 20703