

REMONUMENTATION
 APR 06 1995
 COMMISSION

2-314
 CHARLEVOIX COUNTY REMONUMENTATION
LAND CORNER RECORDATION CERTIFICATE
 Filing Requirement of Act 74, Mich. P.A. 1970
 ALSO ACT 345, PA 1990

STATE OF MICHIGAN
 COUNTY OF CHARLEVOIX
 RECEIVED FOR RECORD
 1994 DEC 22 PM 1:56

For corners in CHARLEVOIX
 (County)

	Located In:	Corner Code -#
1. Public Land Survey	T 32N R 4W	A-6
	T _____ R _____	_____
	T _____ R _____	_____
	T _____ R _____	_____
2. Property Controlling in Section	S _____ T _____ R _____	_____
	S _____ T _____ R _____	_____
3. Miscellaneous Property in Sec.	S _____ T _____ R _____	_____
	S _____ T _____ R _____	_____
4. Lot No. _____, Recorded Plat _____		
5. Private Claims _____		

Charlene M. Cashin
 REGISTER OF DEEDS

Register of Deeds Stamp & File Number

I, Wayne E. Boss, in a field survey on September 27, 19 94, do hereby certify that under requirements of P.A. 74, Michigan P.A. of 1970, the corner points mentioned in lines 1 and 2 above were in conformance with regulations and rules therefore as required in the current manual of survey instructions of the United States Department of the Interior, Bureau of Land Management or by a decree of a Court of Law and/or that the corner points mentioned in lines 3, 4 and 5 above were in conformance with the rules of the Michigan Board of Land Surveyors or by a Decree of a Court of Law; established, re-established, monumented, re-monumented, recovered, found as expressed below:

	A	B	C	D	E	F	G	H	I	J	K	L	M
2	6	5	4	3	2								
3													
4	7	8	9	10	11	12							
5													
6	13	17	16	15	14	13							
7													
8	19	20	21	22	23	24							
9													
10	30	29	28	27	26	25							
11													
12	31	32	33	34	35	36							
13													

NOTE: Not more than 4 corners, all in the same town and range, may be recorded on this certificate.

A. Description of original monument and accessories and/or subsequent restoration:

Set 1/4" Section post
 1. Sugar 14" S21°W 18
 2. Sugar 12" N10°E 49
 John Mullett May 1840

Fd. qr. Section Post
 and Old Wit.
 1902 E.A. Robinson

Fd qr. Section post
 Set 1" pipe and
 3 large stones with
 lot of small stones
 New Wit
 1. Elm S56 3/4°E 182.9' to ctr.
 2. Apple N69 3/4°E 83.8' to ctr.
 1929 E.A. Robinson

Found Boat Spike at
 Kuzmick & Denise Road
 Origin Unknown

B. Description of corner evidence found and/or method applied in restoring or reestablishing corner:


Boat spike found with witness
 No old witnesses found

GLO dist. to A-5, 2640 meas. 2606.54'
 GLO dist. to A-7, 2640 meas. 2644.62'

C. Description of monument for corner and accessories established to perpetuate locating the position of the corner:

A-6 Charlevoix County Mon. set
 1. Set tag cor. fence post S44°W 37.54'
 2. Set tag cor. fence post S44°W 33.19'
 3. Set tag P.P. N51°E 35.31'
 4. North Post of direction sign S85°E 24.03'
 And is accepted as the best available evidence of the position of the original corner.

Charlevoix Co. Surveyor
APPROVED
 Signature Mary C. Ferritt
 Date: 28 31 5 of 1990

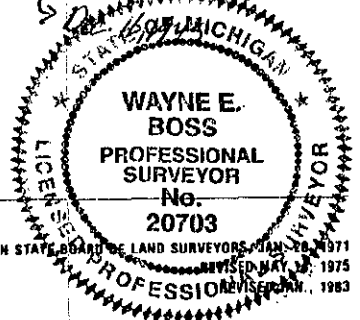

Signed by Wayne E. Boss
 Wayne E. Boss, PS
 Surveyor's Michigan License No. 20703

Date December 14, 1994