

2-359

LAND CORNER RECORDATION CERTIFICATE
Filing Requirement of Act 74, Mich. P.A. 1970

Hudson Township

For corners in
CHARLEVOIX
(County)

Located In: Corner Code #

- 1. Public Land Survey T 32N R 4W Corner Code # A-13
- T R
- T R
- T R
- 2. Property Controlling S T R
- in Section S T R
- 3. Miscellaneous S T R
- Property in Sec. S T R

STATE OF MICHIGAN
COUNTY OF CHARLEVOIX
RECEIVED FOR RECORD

1994 DEC 22 PM 2:32

Charlene M. ...
REGISTER OF DEEDS

Register of Deeds Stamp & File Number

- 4. Lot No. _____, Recorded Plat _____
- 5. Private Claims _____

George J. Avendt, JR. NOV. 17 1994

I, _____, in a field survey on _____, 19____, do hereby certify that under requirements of P.A. 74, Michigan P.A. of 1970, the corner points mentioned in lines 1 and 2 above were in conformance with regulations and rules therefore as required in the current manual of survey instructions of the United States Department of the Interior, Bureau of Land Management or by a decree of a Court of Law and/or that the corner points mentioned in lines 3, 4 and 5 above were in conformance with the rules of the Michigan Board of Land Surveyors or by a Decree of a Court of Law, established, re-established, monumented, re-monumented, recovered, found as expressed below:

	A	B	C	D	E	F	G	H	I	J	K	L	M
2	6	5	4	3	2	1							
3													
4	7	8	9	10	11	12							
5													
6	18	17	16	15	14	13							
7													
8	19	20	21	22	23	24							
9													
10	30	29	28	27	26	25							
11													
12	31	32	33	34	35	36							
13													

NOTE: Not more than 4 corners, all in the same town and range, may be recorded on this certificate.

A. Description of original monument and accessories and/or subsequent restoration:

A-13 CORNER COMMON TO SEC. 31, T32, R4W., SEC. 36, T32N, R5W., SEC. 6, T31N, R4W, & SEC. 1, T31N, R5W.
SURVEYED IN 1840 BY JOHN MULLLETT, DS - G.L.O. -SET SECTION POST SUGAR 12" N44°W 8 LINKS (5.28') - ELM 18" S28°E 11 LINKS (6.6')
SURVEYED 1972 BY CARL F. ROSER, PS 12028. CORNER RE-ESTABLISHED PER STANDARD BLM INSTRUCTIONS (DOUBLE PRORATION TO US). SET DNR MONUMENT.
6" MAPLE N27°W 27.0' - 7" MAPLE N76°W 15.7' - 6" MAPLE S88°E 12.1'
(LIBER 1, PAGE 69)

B. Description of corner evidence found and/or method applied in restoring or reestablishing corner:

A-13 CORNER COMMON TO SEC. 31, T32, R4W., SEC. 36, T32N, R5W., SEC. 6, T31N, R4W, & SEC. 1, T31N, R5W.

FOUND DNR MONUMENT

Charlevoix Co. Surveyor
APPROVED


Signature *Mary C. Fournier*
Date: *Dec 8, 1994*
R.A. 345 of 1990

C. Description of monument for corner and accessories established to perpetuate locating the position of the corner:

A-13 CORNER COMMON TO SEC. 31, T32, R4W., SEC. 36, T32N, R5W., SEC. 6, T31N, R4W, & SEC. 1, T31N, R5W.

FOUND DNR MONUMENT

- N48°E 12.19' 8" MAPLE/CAP #16034
- S82°E 12.36' 10" MAPLE/CAP #16034
- S89°W 8.00' 8" MAPLE/CAP #16034
- N70°W 16.12' 11" MAPLE/CAP #16034
- N39°W 9.23' 7" MAPLE/CAP #16034

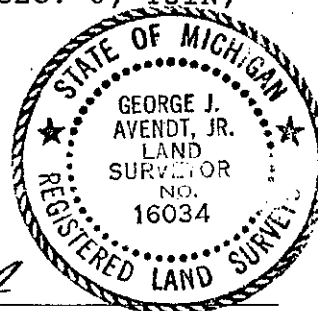

Signed by *George J. Avendt, Jr.*

Date *8 Dec 1994*

Surveyor's Michigan License No. 16034