

SURVEY & REMONUMENTATION

2-360

APR 06 1995

LAND CORNER RECORDATION CERTIFICATE
Filing Requirement of Act 74, Mich. P.A. 1970

Hudson Township

For corners in
CHARLEVOIX
(County)

COMMISSION

Located In: Corner Code #

STATE OF MICHIGAN
COUNTY OF CHARLEVOIX
RECEIVED FOR RECORD

1994 DEC 22 PM 2:33

Charlene M. Cook
REGISTER OF DEEDS

Register of Deeds Stamp & File Number

- 1. Public Land Survey T 32N R 4W Corner Code # B-13
- T _____ R _____
- T _____ R _____
- T _____ R _____
- 2. Property Controlling S _____ T _____ R _____
- In Section S _____ T _____ R _____
- 3. Miscellaneous S _____ T _____ R _____
- Property in Sec. S _____ T _____ R _____

- 4. Lot No. _____, Recorded Plat _____
- 5. Private Claims _____

George J. Avendt, JR. NOV. 17 1994

	A	B	C	D	E	F	G	H	I	J	K	L	M
2	6	5	4	3	2	1							
3													
4	7	8	9	10	11	12							
5													
6	18	17	16	15	14	13							
7													
8	19	20	21	22	23	24							
9													
10	30	29	28	27	26	25							
11													
12	31	32	33	34	35	36							
13													

I, _____, in a field survey on _____, 19____, do hereby certify that under requirements of P.A. 74, Michigan P.A. of 1970, the corner points mentioned in lines 1 and 2 above were in conformance with regulations and rules therefore as required in the current manual of survey instructions of the United States Department of the Interior, Bureau of Land Management or by a decree of a Court of Law and/or that the corner points mentioned in lines 3, 4 and 5 above were in conformance with the rules of the Michigan Board of Land Surveyors or by a Decree of a Court of Law; established, re-established, monumented, re-monumented, recovered, found as expressed below:

NOTE: Not more than 4 corners, all in the same town and range, may be recorded on this certificate.

A. Description of original monument and accessories and/or subsequent restoration:

B-13 QUARTER CORNER COMMON TO SEC. 31, T32, R4W. & SEC. 6, T31N, R4W.
SURVEYED IN 1840 BY JOHN MULLETT, DS - G.L.O SET SECTION POST
SUGAR 20" N30°W 18 LINKS (11.88') - SUGAR 20" N11°E 28 LINKS (18.48')

SURVEYED 1972 BY CARL F. ROSER, PS 12028. CORNER RE-ESTABLISHED PER STANDARD BLM INSTRUCTIONS. SET DNR MONUMENT.
7" MAPLE N73°W 6.3' - 8" MAPLE S22°E 40.7' - 5" MAPLE S87°E 30.5' CTR. E-W TRAIL DUE S. 325' (LIBER 1, PAGE 51)


B. Description of corner evidence found and/or method applied in restoring or reestablishing corner:

B-13 QUARTER CORNER COMMON TO SEC. 31, T32, R4W. & SEC. 6, T31N, R4W.
FOUND 4" ALUMINIUM ROD DNR TABLET 8" ABOVE GROUND

Charlevoix Co. Surveyor
APPROVED
Signature *George J. Avendt*
Date: *Dec 8, 1994*
P.A. 345 of 1970

C. Description of monument for corner and accessories established to perpetuate locating the position of the corner:

B-13 QUARTER CORNER COMMON TO SEC. 31, T32, R4W. & SEC. 6, T31N, R4W.
FOUND 4" ALUMINIUM ROD DNR TABLET 8" ABOVE GROUND
S19°E 40.95' 10" MAPLE/CAP # 16034
N70°W 6.98' 8" MAPLE/CAP # 16034
N17°E 25.60' 7" MAPLE/CAP # 16034
S82°E 30.36' 7" MAPLE/CAP # 16034

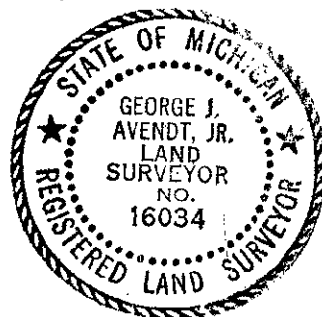

Signed by *George J. Avendt Jr.* Date *Dec 1994*
Surveyor's Michigan License No. 16034