

SURVEY & REMONUMENTATION

MAR 08 1994

COMMISSION

STATE OF MICHIGAN
COUNTY OF CHARLEVOIX
RECEIVED FOR RECORD

1993 DEC -9 AM 11: 42

Charlene M. Caslin
REGISTER OF DEEDS

LAND CORNER RECORDATION CERTIFICATE
Filing Requirement of Act 74, Mich. P.A. 1970

For corners in

Charlevoix
(County)

Located In:

Corner Code =#

1. Public Land Survey	T	32	N	R	4W	F-3
	T		R			
	T		R			
	T		R			
2. Property Controlling in Section	S		T	R		
	S		T	R		
3. Miscellaneous Property in Sec.	S		T	R		
	S		T	R		

Register of Deeds Stamp & File Number

4. Lot No. _____, Recorded Plat _____
5. Private Claims _____

I, George J. Avendt, Jr. in a field survey on November 12, 1993, do hereby certify that under requirements of P.A. 74, Michigan P.A. of 1970, the corner points mentioned in lines 1 and 2 above were in conformance with regulations and rules therefore as required in the current manual of survey instructions of the United States Department of the Interior, Bureau of Land Management or by a decree of a Court of Law and/or that the corner points mentioned in lines 3, 4 and 5 above were in conformance with the rules of the Michigan Board of Land Surveyors or by a Decree of a Court of Law; established, re-established, monumented, re-monumented, recovered, found as expressed below:

NOTE: Not more than 4 corners, all in the same town and range, may be recorded on this certificate.

A. Description of original monument and accessories and/or subsequent restoration:
F-3 corner common to Sections 4 and 9, T32N, R4W

General Land Office
Set beech quarter section post
Sugar 14" N27°E 8 links (5.28')
Sugar 18" S40°W 30 links (19.80')
by William Burt DS, 1850


B. Description of corner evidence found and/or method applied in restoring or reestablishing corner:
F-3 corner common to Sections 4 and 9, T32N, R4W

No evidence was found of the General Land Office post. Found one blazed witness tree and face nail at N84°E 20.88'. No record of the face nail found.
Set Charlevoix County monument by single proration on the line between E-3 and G-3 section corners. The distance between E-3 to G-3 measures 5235.28 feet.

C. Description of monument for corner and accessories established to perpetuate locating the position of the corner:
F-3 corner common to Sections 4 and 9, T32N, R4W

Set Charlevoix County monument.
Witnesses - to nails & tags in trees
Maple 8" N84°E 21.39'
Maple 8" N89°E 20.88'
Maple 9" S39°E 24.20'
Maple 10" S01°E 36.01'
Maple 8" N48°W 22.46'
Basswood 10" N31°E 7.82'

A	B	C	D	E	F	G	H	I	J	K	L	M
2	6		5		4		3		2			
3					●							
4	7		8		9		10		11		12	
5												
6	18		17		16		15		14		13	
7												
8	19		20		21		22		23		24	
9												
10	30		29		28		27		26		25	
11												
12	31		32		33		34		35		36	
13												

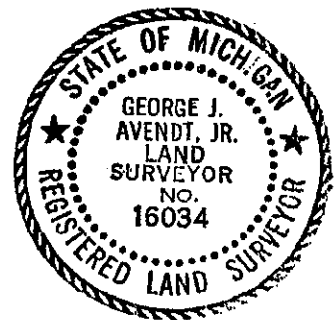

Signed by *George J. Avendt, Jr.*
Surveyor's Michigan License No. 16034

Date December 2, 1993