

SURVEY & REMONUMENTATION

2-362

LAND CORNER RECORDATION CERTIFICATE
Filing Requirement of Act 74, Mich. P.A. 1970

For corners in **APR 06 1995**
CHARLEVOIX

Hudson Township

COMMISSION

	Located In:	Corner Code #
1. Public Land Survey	T 32N R 4W	J-13
	T R	
	T R	
	T R	
2. Property Controlling in Section	S T R	
	S T R	
3. Miscellaneous Property in Sec.	S T R	
	S T R	

STATE OF MICHIGAN
 COUNTY OF CHARLEVOIX
 RECEIVED FOR RECORD
 1994 DEC 22 PM 2:36

Charlene M. Cook
 REGISTER OF DEEDS
 Register of Deeds Stamp & File Number

- 4. Lot No. _____, Recorded Plat _____
- 5. Private Claims _____

	A	B	C	D	E	F	G	H	I	J	K	L	M
2	6	5	4	3	2	1							
3													
4	7	8	9	10	11	12							
5													
6	18	17	16	15	14	13							
7													
8	19	20	21	22	23	24							
9													
10	30	29	28	27	26	25							
11													
12	31	32	33	34	35	36							
13													

I, George J. Avendt, Jr., a field surveyor on NOV. 13, 191994
 do hereby certify that under requirements of P.A. 74, Michigan P.A. of 1970, the corner points mentioned in lines 1 and 2 above were in conformance with regulations and rules therefore as required in the current manual of survey instructions of the United States Department of the Interior, Bureau of Land Management or by a decree of a Court of Law and/or that the corner points mentioned in lines 3, 4 and 5 above were in conformance with the rules of the Michigan Board of Land Surveyors or by a Decree of a Court of Law; established, re-established, monumented, re-monumented, recovered, found as expressed below:

NOTE: Not more than 4 corners, all in the same town and range, may be recorded on this certificate.

A. Description of original monument and accessories and/or subsequent restoration:

J-13 QUARER CORNER SEC. 35, T32N, R4W
SURVEYED IN 1850 BY WILLIAM BURT, DS - G.L.O SET QUARTER SECTION POST
 SUGAR 12" N60°E 25 LINKS (16.50')
 SUGAR 8" N75°W 55 LINKS (36.30')

CONTINUED ON BACK


B. Description of corner evidence found and/or method applied in restoring or reestablishing corner:

J-13 QUARTER CORNER SEC. 35, T32N, R4W
 FOUND 1/2" X 30" IRON ROD, ORIGIN UNKNOWN. NO EVIDENCE FOUND OF G.L.O. POST AND WITNESS TREES.

Charlevoix Co. Surveyor
APPROVED
 Signature Mary C. Fennell
 Date: Dec 8, 1994
 P.A. 34-5 of 1990

C. Description of monument for corner and accessories established to perpetuate locating the position of the corner:

J-13 QUARTER CORNER SEC. 35, T32N, R4W
 REMOVED 1/2" X 30' IRON ROD & SET CHARELVOIX CO. MONUMENT 7" BELOW TRAIL ROAD.
 S39°E 47.95' FOUND 4" CONCRETE MONUMENT 12" ABOVE GROUND
 S65°W 7.89' 8" MAPLE/CAP # 16034
 N37°W 17.40' 13" MAPLE/CAP # 16034
 N63°E 35.63' 10" MAPLE/CAP # 16034
 S55°E 8.20' 9" MAPLE/CAP # 16034
 N51°E 47.93' FOUND 4" CONCRETE MONUMENT 12" ABOVE GROUND
 (67.93' MONUMENT TO MONUMENT)

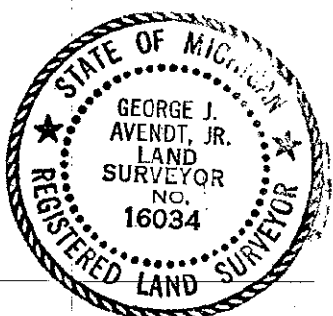

Signed by George J. Avendt, Jr. Date 8 DEC 1994
 Surveyor's Michigan License No. 16034

FILE

1/2
1922

CONTINUATION OF

A. DESCRIPTION OF ORIGINAL MONUMENT AND ACCESSORIES AND/OR
SUBSEQUENT RESORATION:

1/2"x36" IRON BAR SET & WITNESSED BY G.F.DELAMATER, OTSEGO COUNTY
SURVEYOR IN 1922.

CONC. MON. N45°E 48.0'
CONC. MON. S45°E 48.0'