

REMONUMENTATION

APR 06 1995

2-355

COMMISSION

LAND CORNER RECORDATION CERTIFICATE

Filing Requirement of Act 74, Mich. P.A. 1970

Hudson Township

For corners in CHARLEVOIX

	Located In:		Corner Code #
	32N	4W	
1. Public Land Survey	T ___ R ___	___	K-3
	T ___ R ___	___	___
	T ___ R ___	___	___
	T ___ R ___	___	___
2. Property Controlling In Section	S ___ T ___ R ___	___	___
	S ___ T ___ R ___	___	___
3. Miscellaneous Property in Sec.	S ___ T ___ R ___	___	___
	S ___ T ___ R ___	___	___

STATE OF MICHIGAN COUNTY OF CHARLEVOIX RECEIVED FOR RECORD

1994 DEC 22 PM 2:29

Register of Deeds Stamp & File Number

4. Lot No. , Recorded Plat 5. Private Claims

George J. Awendt, JR. NOV. 12 1994

I, in a field survey on 19 do hereby certify that under requirements of P.A. 74, Michigan P.A. of 1970, the corner points mentioned in lines 1 and 2 above were in conformance with regulations and rules therefore as required in the current manual of survey instructions of the United States Department of the Interior, Bureau of Land Management or by a decree of a Court of Law and/or that the corner points mentioned in lines 3, 4 and 5 above were in conformance with the rules of the Michigan Board of Land Surveyors or by a Decree of a Court of Law; established, re-established, monumented, re-monumented, recovered, found as expressed below:

NOTE: Not more than 4 corners, all in the same town and range, may be recorded on this certificate.

	A	B	C	D	E	F	G	H	I	J	K	L	M
2	6		5		4		3		2		1		
3													
4	7		8		9		10		11		12		
5													
6	18		17		16		15		14		13		
7													
8	19		20		21		22		23		24		
9													
10	30		29		28		27		26		25		
11													
12	31		32		33		34		35		36		
13													

A. Description of original monument and accessories and/or subsequent restoration:

K-3 CORNER COMMON TO SEC'S. 1, 2, 11 & 12, T32N, R4W. SURVEYED IN 1850 BY WILLIAM BURT, DS - G.L.O SET SECTION POST BEECH 12" N26°E 46 LINKS (30.36') - SUGAR 10" S52°W 32 LINKS (21.12') SUURVEYED BY GEORGE J. AVENDT, JR, PS 16034 IN 1986. FOUND RAILROAD SPIKE SET BY KENNETH J. OSTLING, PS FOR FORESTRY DIVISION DEPARTMENT OF CONSERVATION, MAY 1962. WITNESSES ARE TO NAILS AND TAGS IN TREES. S28°W 37.93' 36" HEMLOCK - N10°E 43.46' 16" MAPLE - N41°W 89.95' 28" MAPLE - S13°E 73.26' 24" BEECH (LIBER 2, PAGE 242)

B. Description of corner evidence found and/or method applied in restoring or reestablishing corner:

K-3 CORNER COMMON TO SEC'S. 1, 2, 11 & 12, T32N, R4W. FOUND RAILROAD IN ASPHALT ROAD SPIKE SET BY KENNETH J. OSTLING, PS FOR FORESTRY DIVISION DEPARTMENT OF CONSERVATION, MAY 1962

Charlevoix Co. Surveyor

APPROVED

Signature: [Handwritten Signature]


Date: [Handwritten Date]

P.A. 345 of 1990

C. Description of monument for corner and accessories established to perpetuate locating the position of the corner:

K-3 CORNER COMMON TO SEC'S. 1, 2, 11 & 12, T32N, R4W.

SET CHARLEVOIX COUNTY MONUMENT. WITNESSES ARE TO NAILS AND TAGS IN TREES. S28°W 37.93' 36" HEMLOCK N10°E 43.46' 16"MAPLE N41°W 89.95 28"MAPLE S13°E 73.26' 24"BEECH

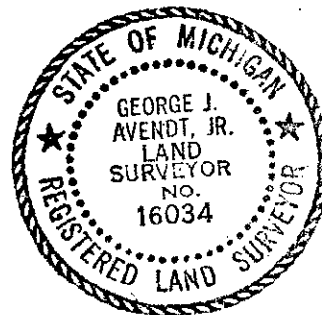

Signed by: [Handwritten Signature]

Date: 8 Dec 1994

Surveyor's Michigan License No. 16034

LIBER 002 PAGE 355