

SURVEY & REMONUMENTATION

APR 06 1995

2-364

LAND CORNER RECORDATION CERTIFICATE
Filing Requirement of Act 74, Mich. P.A. 1970

For corners in **COMMISSION**

Hudson Township

| | | |
|---------------------------------------|--------------------------|---------------|
| <u>Charlevoix</u> County | Located in: | Corner Code # |
| 1. Public Land Survey | T <u>32N</u> R <u>4W</u> | <u>K-13</u> |
| | T _____ R _____ | _____ |
| | T _____ R _____ | _____ |
| | T _____ R _____ | _____ |
| 2. Property Controlling In Section | S _____ T _____ R _____ | _____ |
| 3. Miscellaneous Property in Sec. | S _____ T _____ R _____ | _____ |

STATE OF MICHIGAN
COUNTY OF CHARLEVOIX
RECEIVED FOR RECORD

1994 DEC 22 PM 2:37

Charlene M. Cookin
REGISTER OF DEEDS
Register of Deeds Stamp & File Number

4. Lot No. _____, Recorded Plat _____
5. Private Claims _____

| A | B | C | D | E | F | G | H | I | J | K | L | M |
|----|----|----|----|----|----|----|---|---|---|---|---|---|
| 2 | 6 | 5 | 4 | 3 | 2 | 1 | | | | | | |
| 3 | | | | | | | | | | | | |
| 4 | 7 | 8 | 9 | 10 | 11 | 12 | | | | | | |
| 5 | | | | | | | | | | | | |
| 6 | 18 | 17 | 16 | 15 | 14 | 13 | | | | | | |
| 7 | | | | | | | | | | | | |
| 8 | 19 | 20 | 21 | 22 | 23 | 24 | | | | | | |
| 9 | | | | | | | | | | | | |
| 10 | 30 | 29 | 28 | 27 | 26 | 25 | | | | | | |
| 11 | | | | | | | | | | | | |
| 12 | 31 | 32 | 33 | 34 | 35 | 36 | | | | | | |
| 13 | | | | | | | | | | | | |

I, GEORGE J. AVENDT, JR. in a field survey on MAY 25, 19 94, do hereby certify that under requirements of P.A. 74, Michigan P.A. of 1970, the corner points mentioned in lines 1 and 2 above were in conformance with regulations and rules therefore as required in the current manual of survey instructions of the United States Department of the Interior, Bureau of Land Management or by a decree of a Court of Law and/or that the corner points mentioned in lines 3, 4 and 5 above were in conformance with the rules of the Michigan Board of Land Surveyors or by a Decree of a Court of Law; established, re-established, monumented, re-monumented, recovered, found as expressed below:

NOTE: Not more than 4 corners, all in the same town and range, may be recorded on this certificate.

A. Description of original monument and accessories and/or subsequent restoration:

K-13 SECTION CORNER COMMON TO SECTIONS 35 & 36, T32N, R4W & SECTIONS 1 & 2, T31N, R4W.

GENERAL LAND OFFICE
SET SECTION POST
BEECH 10" N13°W 31 LINKS (20.46')
BEECH 6" N52°E 17 LINKS (11.22')

BY JOHN MULLETT, DS 1840

CONTINUED ON BACK

B. Description of corner evidence found and/or method applied in restoring or reestablishing corner:

K-13 SECTION CORNER COMMON TO SECTIONS 35 & 36, T32N, R4W & SECTIONS 1 & 2, T31N, R4W.


NO EVIDENCE FOUND OF G.L.O. POST OR WITNESSES. FOUND 1/2" X 30" IRON ROD ACCEPTED & USED BY J.L.SCHWANDT, PS 26466 SURVEY IN SECTION 1, T31N, R4W.

*Witnessed by
APPROVED
Signature: Philip S. Turner
Date: APR 22, 1995
P.A. 595 of 1996*

C. Description of monument for corner and accessories established to perpetuate locating the position of the corner:

K-13 SECTION CORNER COMMON TO SECTIONS 35 & 36, T32N, R4W & SECTIONS 1 & 2, T31N, R4W.

REMOVED 1/2" X 30" IRON ROD & SET CHARLEVOIX COUNTY MONUMENT.
N18°E 54.97' 18" BEECH SET NAIL & CHARLEVOIX COUNTY TAG
N58°W 33.08' 12" MAPLE SET NAIL & CHARLEVOIX COUNTY TAG.
S40°E 27.47' 18" MAPLE FOUND NAIL & TAG #26466
S78°W 33.00' 9" MAPLE CLUMP FOUND NAIL AND TAG #26466

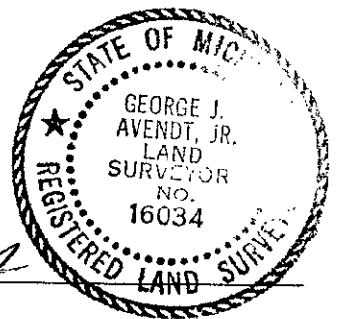

Signed by *George J. Avendt, Jr.*
Surveyor's Michigan License No. 16034

Date 8 DEC 1994

CONTINUATION OF

A. DESCRIPTION OF ORIGINAL MONUMENT AND ACCESSORIES AND/OR
SUBSEQUENT RESTORATION:

SURVEYED BY G.F.DELAMATER, OTSEGO COUNTY SURVEYOR IN 1938
FOUND OLD POST WITH CROCKERY SET 1/2"X36" BAR IN CORNER.

| | | |
|-----------|-------|-------|
| CONC.MON. | S45°W | 48.0' |
| SUGAR 12" | S46°E | 27.9' |