

SURVEY & REMONUMENTATION

2-356

LAND CORNER RECORDATION CERTIFICATE
Filing Requirement of Act 74, Mich. P.A. 1970

HUDSON TOWNSHIP

For corners in **APR 06 1995**

— **CHARLEVOIX** (County) **COMMISSION** Located In: Corner Code #

1. Public Land Survey	T	32N	R	4W	L-3
	T		R		
	T		R		
	T		R		
2. Property Controlling in Section	S		T	R	
	S		T	R	
3. Miscellaneous Property in Sec.	S		T	R	
	S		T	R	

4. Lot No. _____, Recorded Plat _____

5. Private Claims _____

STATE OF MICHIGAN
 COUNTY OF CHARLEVOIX
 RECEIVED FOR RECORD

1994 DEC 22 PM 2:30

Charlene M. ...
 REGISTER OF DEEDS
 Register of Deeds Stamp & File Number

GEORGE J. AVENDT, JR. **MAY 25** **94**
 I, _____, in a field survey on _____, 19 _____,

do hereby certify that under requirements of P.A. 74, Michigan P.A. of 1970, the corner points mentioned in lines 1 and 2 above were in conformance with regulations and rules therefore as required in the current manual of survey instructions of the United States Department of the Interior, Bureau of Land Management or by a decree of a Court of Law and/or that the corner points mentioned in lines 3, 4 and 5 above were in conformance with the rules of the Michigan Board of Land Surveyors or by a Decree of a Court of Law; established, re-established, monumented, re-monumented, recovered, found as expressed below:

NOTE: Not more than 4 corners, all in the same town and range, may be recorded on this certificate.

	A	B	C	D	E	F	G	H	I	J	K	L	M
2	6	5	4	3	2	1							
3													
4	7	8	9	10	11	12							
5													
6	18	17	16	15	14	13							
7													
8	19	20	21	22	23	24							
9													
10	30	29	28	27	26	25							
11													
12	31	32	33	34	35	36							
13													

A. Description of original monument and accessories and/or subsequent restoration:

L-3 QUARTER CORNER COMMON TO SECTIONS 1 & 12, T32N, R4W
 GENERAL LAND OFFICE
 SET BEECH QUARTER SECTION POST
 BEECH 10" S86°E 32 LINKS (21.12')
 BEECH 10" N84°W 47 LINKS (31.02')

BY WM. BURT, DS, 1850

CONTINUED ON BACK


B. Description of corner evidence found and/or method applied in restoring or reestablishing corner:

L-3 QUARTER CORNER COMMON TO SECTIONS 1 & 12, T32N, R4W
 GLO CORNER NOW FALLS IN CENTER LINE OF ASPHALT ROAD & POST OBLITERATED. NO EVIDENCE OF WITNESSES FOUND. FOUND LARGE SPIKE IN ASPHALT IN CENTER LINE OF ROAD. LCRC LI. 002, PG. 169, 1984, CHARLEVOIX COUNTY RECORDS BY GEORGE J. AVENDT, JR, PS 16034, INDICATES THAT G.F. DELAMATER, LS USED THIS SPIKE IN 1926 RUNNING NORTH ON CENTER LINE OF ROAD AND WEST 2618.7 TO K-3.
 N60°E 134.06' SPIKE IN P. POLE
 S32°E 118.22' 12" RED PINE WITH SPIKE
 S46°W 85.90' 10" RED PINE WITH SPIKE
 N61°W 104.30' SE CORNER OF FRAME GARAGE

C. Description of monument for corner and accessories established to perpetuate locating the position of the corner:

L-3 QUARTER CORNER COMMON TO SECTIONS 1 & 12, T32N, R4W
 REMOVED LARGE SPIKE AND SET CHARLEVOIX COUNTY MONUMENT IN BOX.
 S30°E 57.18' TELEPHONE RISER POST NAIL & CAP #16034
 S47°W 85.90' 13" RED PINE NAIL & CAP #16034
 N59°W 104.30' SE CORNER OF FRAME GARAGE
 N48°E 43.91' CENTER OF STREET SIGN POST

Charlevoix Co. Surveyor
APPROVED
 Signature *George J. Avendt, Jr.*
 Date: *Dec 8 1994*

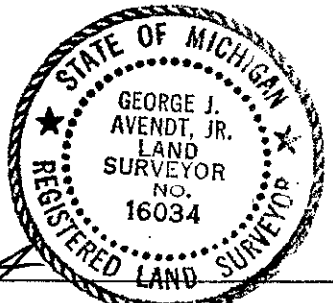

Signed by *George J. Avendt, Jr.* Date *8 Dec 1994*
 Surveyor's Michigan License No. 16034

2.00
2.00

FILE

CONTINUATION OF

A. DESCRIPTION OF ORIGINAL MONUMENT AND ACCESSORIES AND/OR
SUBSEQUENT RESTORATION:

SURVEYED BY E.A. ROBISNSON IN 1927
FORD AXLE 1 FT BELOW SURFACE DISHES CENTER CROSSROADS
SUGAR SHADE 8" N36 30'E 39.3
BLK WALNUT 8" N60 30'W 57.7

IRON STAKES AT CORNERS ROAD BISECTS 33' OFF $\frac{C}{L}$

NO EVIDENCE FOUND OF FORD AXLE OR WITNESSES.