

**SURVEY & REMONUMENTATION**

APR 06 1995

**COMMISSION**

**LAND CORNER RECORDATION CERTIFICATE**  
Filing Requirement of Act 74, Mich. P.A. 1970

STATE OF MICHIGAN  
COUNTY OF CHARLEVOIX  
RECEIVED FOR RECORD

1994 DEC 22 PM 2: 15

*Charlene M. Beckin*  
REGISTER OF DEEDS

For corners in

Charlevoix  
(County)

Located In:

Corner Code #

- |                                       |                          |             |
|---------------------------------------|--------------------------|-------------|
| 1. Public Land Survey                 | T <u>32N</u> R <u>4W</u> | <u>M-12</u> |
|                                       | T _____ R _____          | _____       |
|                                       | T _____ R _____          | _____       |
|                                       | T _____ R _____          | _____       |
| 2. Property Controlling in Section    | S _____ T _____ R _____  | _____       |
|                                       | S _____ T _____ R _____  | _____       |
| 3. Miscellaneous Property in Sec.     | S _____ T _____ R _____  | _____       |
|                                       | S _____ T _____ R _____  | _____       |
| 4. Lot No. _____, Recorded Plat _____ |                          |             |
| 5. Private Claims _____               |                          |             |

Register of Deeds Stamp & File Number

I, ARTHUR R. RANGER, in a field survey on DEC. 14, 1994, do hereby certify that under requirements of P.A. 74, Michigan P.A. of 1970, the corner points mentioned in lines 1 and 2 above were in conformance with regulations and rules therefore as required in the current manual of survey instructions of the United States Department of the Interior, Bureau of Land Management or by a decree of a Court of Law and/or that the corner points mentioned in lines 3, 4 and 5 above were in conformance with the rules of the Michigan Board of Land Surveyors or by a Decree of a Court of Law; established, re-established, monumented, re-monumented, recovered, found as expressed below:

**NOTE: Not more than 4 corners, all in the same town and range, may be recorded on this certificate.**

A	B	C	D	E	F	G	H	I	J	K	L	M
2	6	5	4	3	2							
3												
4	7	8	9	10	11	12						
5												
6	18	17	16	15	14	13						
7												
8	19	20	21	22	23	24						
9												
10	30	29	28	27	26	25						
11												
12	31	32	33	34	35	36						
13												

A. Description of original monument and accessories and/or subsequent restoration:

- 1840- John Mullet, Surveyor set Qr. section post and witnessed: Sugar 20" S81°E 25 lks; Beech 12" N49°W 14lks
- 18-- E.K. Robinson, Surveyor found and used corner and witnessed: Sugar 20" S81°E 25 lks; Beech 12" N49°W 14 lks; Beech 12" N52°W 44 lks
- 1927- G.F. Delamater, Surveyor found Gov't beech plainly marked; Set a 1/2"x30" bar and witnessed: Stone 8"x18" S49°E 10.3'; R.R. iron N49°W 29.2'.


B. Description of corner evidence found and/or method applied in restoring or reestablishing corner:

- 1993/
- 1994- Found 1/2"x30" bar by G.F. Delamater and all witnesses; The Gov't beech was gone, except for some stump remains; The distance and bearing to the stump were reasonable; The corner fit the Town line bearing. The corner was accepted.

C. Description of monument for corner and accessories established to perpetuate locating the position of the corner:

- M-12 Replaced the 1/2"x30" bar by G.F.D. with a 4" dia. Harrison monument 20" long. Witnesses:  
R.R. iron N40°W 29.31'  
Set X in stone S36°E 10.54'  
15" Beech S60°E 26.75'  
5" Maple N74°E 22.16'  
10" Beech N28°E 6.77'  
12" Beech N66°W 9.04'

Charlevoix Co. Surveyor  
**APPROVED**  
Signature Mary C. Ferrett  
Date: Dec 15, 1994  
Public Act 345 of 1990

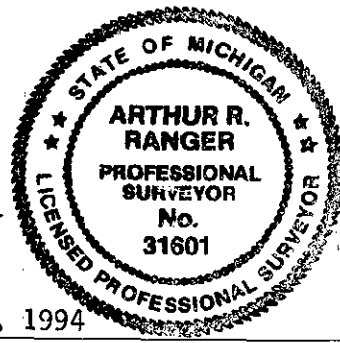

Signed by Arthur R. Ranger Date Dec. 14, 1994

Surveyor's Michigan License No. 31601