

LAND CORNER RECORDATION CERTIFICATE

FILING REQUIREMENT OF ACT 74, MICH. P.A.1970

FOR CORNERS OF--:	LOCATED IN--:	CORNER CODE NUMBER
1. PUBLIC LAND SURVEY	T. 32 N. R. 5 W.	C-9; C-10
2. PROPERTY CONTROLLING IN SECTION 29	T. 32 N. R. 5 W.	3; 14
3. MISCELLANEOUS PROPERTY IN SECTION	T. S. R. E. W.	
4. LOT NO. _____, RECORDED PLAT _____		
5. PRIVATE CLAIMS _____		

REGISTER OF DEEDS STAMP AND FILING NUMBER _____

I, Carl F. Roser, do hereby certify that under requirements of P.A. 74, Michigan P.A. of 1970, the corner points mentioned in lines 1 and 2 above were, in a field survey on August 19, 1975, established, re-established, monumented, re-monumented, recovered or restored as expressed below and in conformance with regulations and rules therefore as required in the current manual of survey instructions of the United States Department of the Interior, Bureau of Land Management or by a decree of a court of law. Furthermore, that the corner points mentioned in lines 3, 4 and 5 above were, in a field survey on _____, 19____, found, recovered, restored, established or re-established as expressed below and in conformance with the rules of the Michigan State Board of Registration for Land Surveyors or, by a Decree of a Court of law:

~~A. Description of original monument and accessories and/or subsequent restoration:~~

C. (continued)

14
 Found RR iron (upright)
 20" W. Pine S17°W 27.6
 6" Cedar N82°W 58.4
 Corner Fn. Post N45°E 48.5
 Set cedar post w/loc. tag
 Due W 33'

B. Description of corner evidence found and/or method applied in restoring or re-establishing corner:

- C-9 Found pt. of EA Robinson's stake along side bottom 30" of govt. stake for corner. Corner falls in old tote road.
- C-10 Recovered 4"x5"x5' cedar post as set by EA Robinson in 1904± at found ¼ corner.
- 3 Established corner by single proportion.
- 14 Recovered narrow gauge RR iron flush in old road grade, in line with county road to east and north.

C. Description of monument for corner and accessories established to perpetuate locating the position of the corner:

C-9	C-10	3
Set 1¼"x40" well pt. w/DNR cap	Set 1¼"x48" well pt. w/DNR cap & cedar post	Set 1¼"x48" pipe & cedar post w/loc. tag
18" W. Pine N86°E 13.2	16" W. Pine S73°E 10.3	18" W. Pine S74°W 35.2
9" Cedar S53°E 31.2	9" Cedar S48°W 12.5	7" W. Pine N74°W 33.3
10" Cedar S21°W 14.5	6" Cedar N68°W 11.1	9" Cedar S25°E 18.4
16" Cedar N53°W 12.1	5" Cedar N01°E 9.4	6" Cedar N05°E 18.9
Stream (25 links) North 1.06 ch.	Old N-S tote rd. Due W 35'±	Old EA Robinson Post N87°E 7.7
		Old N-S tote rd. Due W 30'±


SIGNED BY Carl F. Roser DATE 4-26-76

SURVEYOR'S MICHIGAN REGISTRATION NO. 12028

FOR STATE AND UNITED STATES AGENCIES:

SIGNED BY _____ DATE _____

APPROVED AND SIGNED BY _____ DATE _____

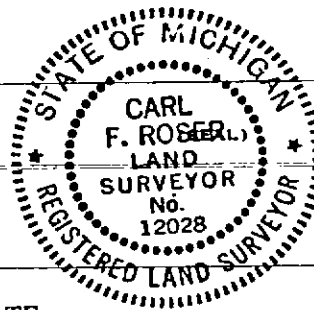

MICHIGAN REGISTERED LAND SURVEYOR (SEAL)

BOYNE VALLEY TOWNSHIP
CHARLEVOIX COUNTY

SURVEYOR'S MICHIGAN REGISTRATION NO. _____