

LAND CORNER RECORDATION CERTIFICATE

FILING REQUIREMENT OF ACT 74, MICH. P.A.1970

FOR CORNERS OF--:	LOCATED IN--:	CORNER CODE NUMBER
1. PUBLIC LAND SURVEY	T. 32 N., R. 5 W.	E-9; E-10
2. PROPERTY CONTROLLING IN SECTION 29	T. 32 N., R. 5 W.	1; 2
3. MISCELLANEOUS PROPERTY IN SECTION	T. _____ N. S., R. _____ E. W.	
4. LOT NO. _____, RECORDED PLAT _____		
5. PRIVATE CLAIMS _____		

REGISTER OF DEEDS STAMP AND FILING NUMBER

I, Carl F. Roser, do hereby certify that under requirements of P.A. 74, Michigan P.A. of 1970, the corner points mentioned in lines 1 and 2 above were, in a field survey on August 19, 1975, established, re-established, monumented, re-monumented, recovered or restored as expressed below and in conformance with regulations and rules therefore as required in the current manual of survey instructions of the United States Department of the Interior, Bureau of Land Management or by a decree of a court of law. Furthermore, that the corner points mentioned in lines 3, 4 and 5 above were, in a field survey on _____, 19____, found, recovered, restored, established or re-established as expressed below and in conformance with the rules of the Michigan State Board of Registration for Land Surveyors or, by a Decree of a Court of law:

A. ~~Description of original monument and accessories and/or subsequent restoration~~
 C. (continued) 2

Set 1 1/4"x36" well pt. & cedar post w/loc. tag
 P. Pole N07°W 59.00
 8" Maple N60°E 14.3
 12" Ash S25°E 62.0
 Old fence corner N08°W 2.8'


- B. Description of corner evidence found and/or method applied in restoring or re-establishing corner:
- E-9 Recovered narrow gauge RR iron, on end, at a depth of 4.7 ft. in old road grade (fill). Fits EA Robinson survey dated 1904±. Corner falls in approximate road intersection E-W-S.
 - E-10 Recovered pointed stake bottom in old N-S swp. road (corduroy). Fits EA Robinson survey in 1904±.
 - 1 Established corner, single proportion.
 - 2 Established corner single proportion which fits old corner fence post (fence N-S-E) very close & Robinson survey.

C. Description of monument for corner and accessories established to perpetuate locating the position of the corner:

E-9	E-10	1
Found RR iron & raised with 1"x60" pipe	Found stake & drove 1 1/4"x36" pipe	Set 1 1/4"x36" pipe & cedar post w/loc. tag
P. Pole N33°W 46.65	9" Cedar S31°W 44.5	6" Twin Oak N89°E 9.0
Corner Fn. post N15°E 39.42	16" W. Pine N77°W 40.3	14" Maple N43°W 37.6
16" Maple S43°W 37.85	9" Cedar N44°W 27.6	16" B. Cherry N74°W 48.8
Set cedar post w/loc. tag Due N 33.0	Old fn. to E&W Due S 8'±	Old N-S b'wire fence Due E 6.5
	Set cedar post w/loc. tag Due W 33'	

SIGNED BY Carl F. Roser DATE 4-26-76

SURVEYOR'S MICHIGAN REGISTRATION NO. 12028

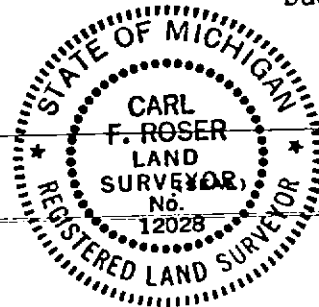

FOR STATE AND UNITED STATES AGENCIES:

SIGNED BY _____ DATE _____

APPROVED AND SIGNED BY _____ DATE _____

SURVEYOR'S MICHIGAN REGISTRATION NO. _____

BOYNE VALLEY TOWNSHIP
CHARLEVOIX COUNTY