

# LAND CORNER RECORDATION CERTIFICATE

## FILING REQUIREMENT OF ACT 74, MICH. P.A.1970

FOR CORNERS OF--:	LOCATED IN--:	CORNER CODE NUMBER
1. PUBLIC LAND SURVEY	T. 32 N. R. 5 W.	D-9
2. PROPERTY CONTROLLING IN SECTION	29 T. 32 N. R. 5 W.	7; 9; 10
3. MISCELLANEOUS PROPERTY IN SECTION	T. N. S. R. E. W.	
4. LOT NO. _____, RECORDED PLAT _____		
5. PRIVATE CLAIMS _____		

REGISTER OF DEEDS STAMP AND FILING NUMBER

I, Carl F. Roser, do hereby certify that under requirements of P.A. 74, Michigan P.A. of 1970, the corner points mentioned in lines 1 and 2 above were, in a field survey on August 26, 1975, established, re-established, monumented, re-monumented, recovered or restored as expressed below and in conformance with regulations and rules therefore as required in the current manual of survey instructions of the United States Department of the Interior, Bureau of Land Management or by a decree of a court of law. Furthermore, that the corner points mentioned in lines 3, 4 and 5 above were, in a field survey on \_\_\_\_\_, 19\_\_\_\_, found, recovered, restored, established or re-established as expressed below and in conformance with the rules of the Michigan State Board of Registration for Land Surveyors or, by a Decree of a Court of law:

~~As Description of original monument and accessories and as subsequently established:~~

- C. (continued)
- |   |
|---|
| 10  |
| Set 1 1/4"x48" pipe & cedar post w/loc. tag |
| 12" hemlock S28°E 15.3                      |
| 7" Cedar S23°W 9.3                          |
| 18" W. Pine N52°W 43.8                      |
| 8" Tamarack N12°E 29.9                      |

- B. Description of corner evidence found and/or method applied in restoring or re-establishing corner:
- D-9 Restored 1/4 corner on split of old R.O.W. fences to west & in line with old fence to N & S which fits EA Robinson survey in 1904±.
  - 7 Found old water hand pump barrel; 12"± long (broken) in ctr. of N-S dirt road & in line with fence to west; corner fits old witness by EA Robinson dated 1904±.
  - 9 Established corner per standard B.L.M. instructions; old RR grade is N00°46'E 210'±.
  - 10 Established corner single proportion.

C. Description of monument for corner and accessories established to perpetuate locating the position of the corner:

D-9	7	9
Set 1 1/4"x36" pipe in old E-W rd.	Found iron & added 1"x20" iron rod	Set 1 1/4"x72" pipe & cedar post w/loc. tag
Set cedar post w/loc. tag	Cedar post w/loc. tag	8" Cedar N43°W 19.3
16" Maple Due S 33' S08°E 22.66	Due W 33'	8" Cedar N43°E 9.0
10" Maple S56°W 27.10	30" Oak N63°W 51.20	12" W. Pine S01°E 35.3
12" Maple N35°E 21.23	SE corner concrete foundation N39°W 100.0	7" Cedar S43°W 24.2
		N.bank stream 12' C-W S 64'


SIGNED BY Carl F. Roser DATE 4-26-76

SURVEYOR'S MICHIGAN REGISTRATION NO. 12028

FOR STATE AND UNITED STATES AGENCIES:

SIGNED BY \_\_\_\_\_ DATE \_\_\_\_\_

APPROVED AND SIGNED BY \_\_\_\_\_ DATE \_\_\_\_\_

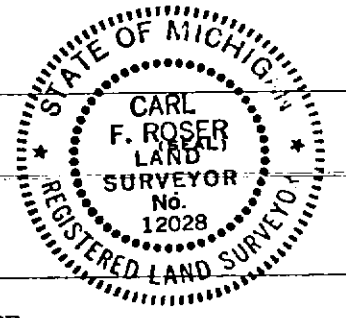

BOYNE VALLEY TOWNSHIP  
CHARLEVOIX COUNTY

SURVEYOR'S MICHIGAN REGISTRATION NO. \_\_\_\_\_