

LAND CORNER RECORDATION CERTIFICATE

FILING REQUIREMENT OF ACT 74, MICH. P.A.1970

FOR CORNERS OF--:	LOCATED IN--:	CORNER CODE NUMBER
1. PUBLIC LAND SURVEY.....	T. 32 N. R. 5 W.	A-11; E-11; F-11; G-11
2. PROPERTY CONTROLLING IN SECTION.....	T. N. S. R. E. W.	
3. MISCELLANEOUS PROPERTY IN SECTION.....	T. N. S. R. E. W.	
4. LOT NO. _____, RECORDED PLAT _____		
5. PRIVATE CLAIMS _____		

REGISTER OF DEEDS STAMP AND FILING NUMBER

I, Carl F. Roser, do hereby certify that under requirements of P.A. 74, Michigan P.A. of 1970, the corner points mentioned in lines 1 and 2 above were, in a field survey on June 30, 1975, established, re-established, monumented, re-monumented, recovered or restored as expressed below and in conformance with regulations and rules therefore as required in the current manual of survey instructions of the United States Department of the Interior, Bureau of Land Management or by a decree of a court of law. Furthermore, that the corner points mentioned in lines 3, 4 and 5 above were, in a field survey on _____, 19____, found, recovered, restored, established or re-established as expressed below and in conformance with the rules of the Michigan State Board of Registration for Land Surveyors or, by a Decree of a Court of law:

A. Description of original monument and accessories and/or subsequent restoration:
 C. (continued)

G-11
 Found 3/8" pipe & drove 1 1/4"x36" pipe in gravel road
 P. Pole S14°E 108.25
 5" Maple N27°W 30.19
 Cor.Fn.Post S88°E 35.00
 Set cedar post w/loc. tag Due W 33'
 Center N-S co. rd. Due E 3'


- B. Description of corner evidence found and/or method applied in restoring or re-establishing corner:
- A-11 Found PK nail over axle shaft in center of N-S blacktop county road and center of gravel road west. Fence to east is 24' north.
 - E-11 Found US BT (8" tam.stump) N52°W, 16.4' & points of 2 each 3" cedar stakes in place in swamp; good original US corner; we have cut-in random lines that run W-N-S from this corner.
 - F-11 Found 1 1/4" pipe (flush-off road) from one witness; per EA Robinson survey for road, dated September 1921. EAR restored corner from one US BT; corner is in line with gravel road to N & E.
 - G-11 Found 3/8" pipe; fits Robinson surveys of record, dated 1906 and 1921.

C. Description of monument for corner and accessories established to perpetuate locating the position of the corner:

A-11	E-11	F-11
Found 1"x36" axle shaft	Drove 1-1/8"x72" iron rod w/ flange & nut & ced.post w/loc. tag	Found 1 1/4" pipe & set cedar post w/loc. tag
20" W. Pine N55°W 91.40	10" Cedar S13°W 12.9	7" Cedar N71°W 17.1
P.Pole S70°W 83.06	8" Cedar S45°E 13.9	7" Cedar S48°W 13.4
P.Pole N27°E 118.47	8" Tamarack S86°E 58.4	9" Cedar S11°W 40.3
Cedar post w/loc. tag Due E 33'	18" W.Pine N37°E 48.4	10" Tamarack N47°E 61.6
	18" W.Pine N50°W 69.9	

SIGNED BY Carl F. Roser DATE 4-26-76

SURVEYOR'S MICHIGAN REGISTRATION NO. 12028

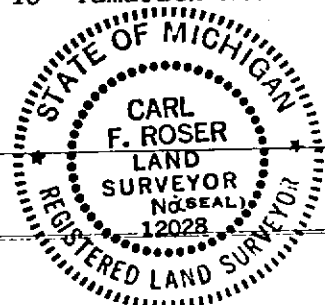

FOR STATE AND UNITED STATES AGENCIES:

SIGNED BY _____ DATE _____
CHIEF OF SURVEY PARTY

APPROVED AND SIGNED BY _____ DATE _____
MICHIGAN REGISTERED LAND SURVEYOR (SEAL)

SURVEYOR'S MICHIGAN REGISTRATION NO. _____
 BOYNE VALLEY TOWNSHIP
 CHARLEVOIX COUNTY