

LAND CORNER RECORDATION CERTIFICATE

FILING REQUIREMENT OF ACT 74, MICH. P.A.1970

FOR CORNERS OF--:	LOCATED IN--:	CORNER CODE NUMBER
1. PUBLIC LAND SURVEY _____	T. 32 ^{N.} R. 5 ^{W.}	A-10; A-13; D-10
2. PROPERTY CONTROLLING IN SECTION 30 _____	T. 32 ^{N.} R. 5 ^{W.}	3
3. MISCELLANEOUS PROPERTY IN SECTION _____	T. _____ ^{N.} R. _____ ^{E.}	_____
4. LOT NO. _____, RECORDED PLAT _____		
5. PRIVATE CLAIMS _____		

REGISTER OF DEEDS STAMP AND FILING NUMBER

I, Carl F. Roser, do hereby certify that under requirements of P.A. 74, Michigan P.A. of 1970, the corner points mentioned in lines 1 and 2 above were, in a field survey on October 30, 1975, established, re-established, monumented, re-monumented, recovered or restored as expressed below and in conformance with regulations and rules therefore as required in the current manual of survey instructions of the United States Department of the Interior, Bureau of Land Management or by a decree of a court of law. Furthermore, that the corner points mentioned in lines 3, 4 and 5 above were, in a field survey on _____, 19____, found, recovered, restored, established or re-established as expressed below and in conformance with the rules of the Michigan State Board of Registration for Land Surveyors or, by a Decree of a Court of law:

A = Description of original monument and accessories and/or subsequent restorations
 C. (continued)

- 3
- Drove 1"x15" Pipe
 - Fd. 1/2" rod N10°W 0.5
 - 10" Tamarack S45°E 92.4
 - 10" Tamarack N64°E 91.7
 - 12" Cedar N75°W 72.5
 - P.Pole S48°W 70.48
 - Set cedar post w/loc. tag Due E 33'

- B. Description of corner evidence found and/or method applied in restoring or re-establishing corner:
- A-10 Found 1/2" rerod and drove 1"x12" pipe over it; corner falls in center of N-S b'top county road. A concrete U.S.G.S. B.M. is N25°E, 83.65'.
 - A-13 Replaced "PK" from our 1970 survey with 1 1/4" iron pin; corner falls in center of N-S b'top county road & in line with center of gravel road west and old fence east. One-eighth line fence, 1/4 mile north (to W) is on split of distance between SW corner of Sec. 31 (four twp. corner) as estab. & recovered W 1/4 corner of Sec. 31. Corner previously recovered & used by RLS Gene Ostling; Liber 205, page 471, Antrim County Corner Records.
 - D-10 Established center of Sec. 29 at intersection of 1/4 line; old RR grade is N00°41'E, 605'±.
 - 3 Established corner per standard B.L.M. instructions; ctr. of N-S b'top co.rd. is due E 2'.
- C. Description of monument for corner and accessories established to perpetuate locating the position of the corner:

A-10	A-13	D-10
Drove 1"x12" pipe	Drove 1 1/4"x30" Iron Pin	Set 1 1/4"x72" pipe & cedar post w/loc. tag
P.Pole S88°E 29.60	Conc.FAS Mon. Due E 33'	16" Cedar S02°W 28.0
HiLine PPole N18°E 192.74	Set cedar post w/loc. tag Due E 33'	16" W. Pine N83°W 27.2
Fd. 1/2" "T" Iron N86°W 49.50	PP (RLS face tag #12026) N43°W 42.45	12" Cedar N52°W 36.4
10" Poplar S62°W 80.7	Anchor Pole (face tag 12026) N50°E 50.5	10" Cedar N33°E 36.9
Set cedar post w/loc. tag Due E 33'		12" Cedar N82°E 33.6


SIGNED BY Carl F. Roser 4-26-76 DATE _____

SURVEYOR'S MICHIGAN REGISTRATION NO. 12028

FOR STATE AND UNITED STATES AGENCIES:

SIGNED BY _____ DATE _____

APPROVED AND SIGNED BY _____ DATE _____

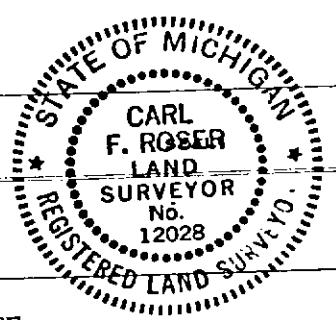

SURVEYOR'S MICHIGAN REGISTRATION NO. _____ BOYNE VALLEY TOWNSHIP CHARLEVOIX COUNTY