

STATE OF MICHIGAN
DEPARTMENT
OF
NATURAL RESOURCES

LAND CORNER RECORD

CHARLEVOIX COUNTY


T 32 N R 5 W

DESCRIPTION OF CORNER E 1/4 corner, Section 36

CORNER MONUMENT Set DNR Monument

DATE MONUMENT PLACED AND WITNESSED 10-15-71

WITNESSES TO CORNER..... 2 1/2" Beech S 29 W 72.7'

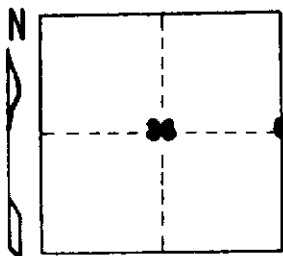

1 1/2" Maple N 40 W 52.2'


8" Apple 4-cluster S 50 E 73.3'

AND E-W Trail Rd. Due N 115'

CIRCLE CORNER REGISTERED N-S Random Due E 160'

DESCRIPTION IN DETAIL AS TO HOW CORNER WAS LOCATED AND IDENTIFIED OR RESTORED.

Corner reestablished per standard NLS instructions.

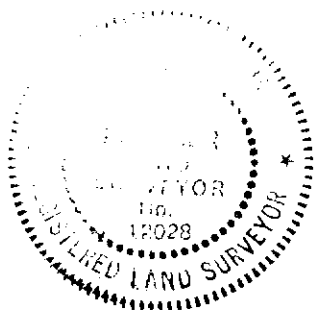

SURVEYOR'S SEAL

SIGNED Carl F. Rose

DATE 10-22-71

DISTRIBUTION:

REGISTERED LAND SURVEYOR 12028

County Courthouse
Area Forester (Regions I & II)
District or Region Surveyor
Forestry Div., Lansing

R 4047
Rev. 10/68