

STATE OF MICHIGAN
DEPARTMENT
OF
NATURAL RESOURCES

LAND CORNER RECORD

CHARLEVOIX COUNTY


T 82 N R 5 W

DESCRIPTION OF CORNER NE corner of Sec. 36

CORNER MONUMENT Found concrete Monument with sq. Cedar post

DATE MONUMENT PLACED AND WITNESSED 10-20-71

WITNESSES TO CORNER..... 5" Maple N 9 W 22.8'

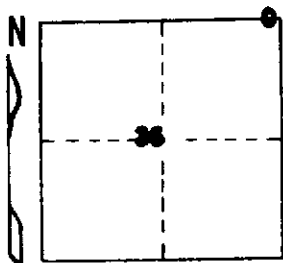

6" Maple N 51 E 20.6'


7" Maple S 47 E 22.4'

AND

CIRCLE CORNER REGISTERED

DESCRIPTION IN DETAIL AS TO HOW CORNER WAS LOCATED AND IDENTIFIED OR RESTORED.

Recovered corner (conc. mon.) as reestablished by R.L.S. T. F. Schweigert in 1958 and on record at Charlevoix County Register of Deeds.

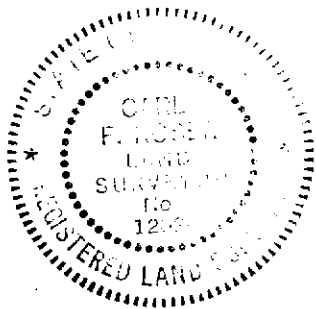

SURVEYOR'S SEAL

SIGNED

Carl F. Rose

DATE

12-27-71

DISTRIBUTION:

REGISTERED LAND SURVEYOR 12028

County Courthouse
Area Forester (Regions I & II)
District or Region Surveyor
Forestry Div., Lansing

R 4047
Rev. 10/68