

LAND CORNER RECORDATION CERTIFICATE

FILING REQUIREMENT OF ACT 74, MICH. P.A. 1970

| FOR CORNERS OF--: | LOCATED IN--: | CORNER CODE NUMBER |
|---------------------------------------|---|--------------------|
| 1. PUBLIC LAND SURVEY | T. <u>32</u> N. <u>●</u> , R. <u>5</u> W. <u>●</u> | <u>I-3, I-2</u> |
| 2. PROPERTY CONTROLLING IN SECTION | T. _____ N. _____ S. _____ R. _____ E. _____ W. _____ | _____ |
| 3. MISCELLANEOUS PROPERTY IN SECTION | T. _____ N. _____ S. _____ R. _____ E. _____ W. _____ | _____ |
| 4. LOT NO. _____, RECORDED PLAT _____ | | |
| 5. PRIVATE CLAIMS _____ | | |

REGISTER OF DEEDS STAMP AND FILING NUMBER

I, Carl F. Roser, do hereby certify that under requirements of P.A. 74, Michigan P.A. of 1970, the corner points mentioned in lines 1 and 2 above were, in a field survey on October 7, 1981, established, re-established, monumented, re-monumented, recovered or restored as expressed below and in conformance with regulations and rules therefore as required in the current manual of survey instructions of the United States Department of the Interior, Bureau of Land Management or by a decree of a court of law. Furthermore, that the corner points mentioned in lines 3, 4 and 5 above were, in a field survey on _____, 19____, found, recovered, restored, established or re-established as expressed below and in conformance with the rules of the Michigan State Board of Registration for Land Surveyors or, by a Decree of a Court of law:

A. Description of original monument and accessories and/or subsequent restoration:

B. Description of corner evidence found and/or method applied in restoring or re-establishing corner:

- I-3 Drove 1/2" x 24" rerod (buried) in approx. ctr. of N-S gravel county road at double distance & on line across fd. S1/4 cor. & E 1/8 cor. on S. line of Sec. 3 per E.A. Robinson sur. of South Line of Sec. 3, Oct. 1913; see small red field book in jury room (old Co. sur. rec.) "Boyne Valley" pg. 17.
- I-2 Fd. 3 old 8" x 4" logging chain links (together) vertical surrounded by 3 large stones & many smaller rocks buried one foot & deeper; in side hill road cut & fill in side hill marsh-believed to be result of E.K. Robinson survey, Jan. 1898 (F.B.#12) and E.A. Robinson survey for road in Sec. 2, dated Feb. 19 & 20, 1906, map 2-32-5 in drawer of old county surveyors records in jury across from Register of Deeds.

C. Description of monument for corner and accessories established to perpetuate locating the position of the corner:

| | |
|--|--|
| <p style="text-align: center;">I-3</p> <p>Drove 1/2" x 24" rerod w/plastic cap. P. Pole (side nail) S53°W 52.80 St. cut in side of 12" ced. N50°W 77.75 Drove 5/8" x 36" rerod & set ced. post w/loc tag. N89°09'W 33.00</p> | <p style="text-align: center;">I-2</p> <p>Drove 5/8" x 36" rerod w/plastic cap by large vertical logging ch. P. Pole w/Transf. S42°W 45.22 Metal rd. sign pipe post N20°E 27.25 Guy Pole N42°W 42.60 Old cor. fn. post (leaning) with fn. remains N & E is 32'± N & 5'± E. Irregular "T" rd. inter is approx. 5' S & 2' E.</p> |
|--|--|

SIGNED BY Carl F. Roser 01-12-82 DATE _____


SURVEYOR'S MICHIGAN REGISTRATION NO. 12028

FOR STATE AND UNITED STATES AGENCIES:

SIGNED BY _____ DATE _____

APPROVED AND SIGNED BY _____ DATE _____

SURVEYOR'S MICHIGAN REGISTRATION NO. _____

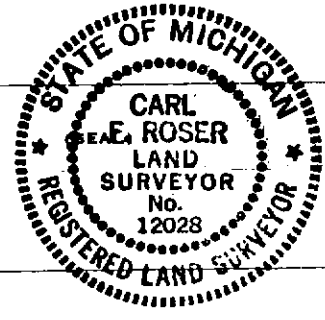

CHARLEVOIX COUNTY
BOYNE VALLEY TOWNSHIP