

2-343

LAND CORNER RECORDATION CERTIFICATE
Filing Requirement of Act 74, Mich. P.A. 1970

BOYNE VALLEY TOWNSHIP

For corner
CHARLEVOIX
(County)

Located In: Corner Code #

1. Public Land Survey	T	32N	R	5W	A-3
	T		R		
	T		R		
	T		R		
2. Property Controlling in Section	S		T	R	
	S		T	R	
3. Miscellaneous Property in Sec.	S		T	R	
	S		T	R	

STATE OF MICHIGAN
COUNTY OF CHARLEVOIX
RECEIVED FOR RECORD

1994 DEC 22 PM 2: 18

Charlene M. Peckin
REGISTER OF DEEDS

Register of Deeds Stamp & File Number

- 4. Lot No. _____, Recorded Plat _____
- 5. Private Claims _____

George J. Awendt, JR. NOV. 22 1994

I, _____, in a field survey on _____, 19 _____, do hereby certify that under requirements of P.A. 74, Michigan P.A. of 1970, the corner points mentioned in lines 1 and 2 above were in conformance with regulations and rules therefore as required in the current manual of survey instructions of the United States Department of the Interior, Bureau of Land Management or by a decree of a Court of Law and/or that the corner points mentioned in lines 3, 4 and 5 above were in conformance with the rules of the Michigan Board of Land Surveyors or by a Decree of a Court of Law; established, re-established, monumented, re-monumented, recovered, found as expressed below:

NOTE: Not more than 4 corners, all in the same town and range, may be recorded on this certificate.

A	B	C	D	E	F	G	H	I	J	K	L	M
2	6	5	4	3	2	1						
3	7	8	9	10	11	12						
4												
5												
6	18	17	16	15	14	13						
7												
8	19	20	21	22	23	24						
9												
10	30	29	28	27	26	25						
11												
12	31	32	33	34	35	36						
13												

A. Description of original monument and accessories and/or subsequent restoration:

A-3 CORNER COMMON TO SEC'S. 6 & 7, T32N, R5W. & SEC'S. 1 & 12, T32N, R6W. SURVEYED IN 1839 BY JOHN HODGSON, DS - G.L.O. - SECTION CORNER POST BEECH 12" S69°W 40 LINKS (26.4') - BIRCH 6" N32°W 35 LINKS (23.1')

SURVEYED 1974 BY CARL F. ROSER, PS 12028. FOUND 1-1/2" PIPE FOR SW CORNER OF SEC. 6. RAISED WITH 1" PIPE. 12" MAPLE N66°E 43.70' - 10" MAPLE N30°E 53.38' CORNER FENCE POST DUE SOUTH 26' LIBER 2, PAGE 5

B. Description of corner evidence found and/or method applied in restoring or reestablishing corner:


A-3 CORNER COMMON TO SEC'S. 6 & 7, T32N, R5W. & SEC'S. 1 & 12, T32N, R6W. FOUND 1" PIPE.

Charlevoix Co. Surveyor
APPROVED
Signature *Dyan C. Ferrell*
Date: *Dec 8, 1994*
P.A. 345, 1990.

C. Description of monument for corner and accessories established to perpetuate locating the position of the corner:

A-3 CORNER COMMON TO SEC'S. 6 & 7, T32N, R5W. & SEC'S. 1 & 12, T32N, R6W. FOUND 1" PIPE. REPLACED WITH CHARLEVOIX COUNTY MONUMENT.

- S76°E 128.39' POWER POLE/CAP # 16034
- S17°E 59.93' 5" RED PINE/CAP # 16034
- S81°W 108.97' POWER POLE/CAP # 16034
- N50°E 59.17' 12" MAPLE/CAP # 16034

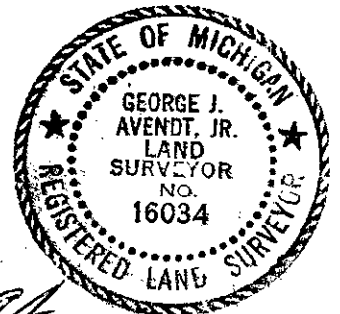

Signed by *George J. Awendt, Jr.* Date *8 Dec 1994*
Surveyor's Michigan License No. 16034