

2-352

REMONUMENTATION  
APR 06 1995  
COMMISSION

LAND CORNER RECORDATION CERTIFICATE  
Filing Requirement of Act 74, Mich. P.A. 1970

BOYNE VALLEY TOWNSHIP

For corners in CHARLEVOIX (County)

Located In:	Corner Code #
T 32N R 5W	A-11
T R	
T R	
T R	
T R	
S T R	
S T R	
S T R	
S T R	

STATE OF MICHIGAN  
COUNTY OF CHARLEVOIX  
RECEIVED FOR RECORD

1994 DEC 22 PM 2:25

*Charles M. Pasch*  
REGISTER OF DEEDS

Register of Deeds Stamp & File Number

- Public Land Survey
- Property Controlling in Section
- Miscellaneous Property in Sec.
- Lot No. \_\_\_\_\_, Recorded Plat \_\_\_\_\_
- Private Claims \_\_\_\_\_

George J. Avendt, JR. NOV. 16 1994

I, \_\_\_\_\_, in a field survey on \_\_\_\_\_, 19\_\_\_\_\_, do hereby certify that under requirements of P.A. 74, Michigan P.A. of 1970, the corner points mentioned in lines 1 and 2 above were in conformance with regulations and rules therefore as required in the current manual of survey instructions of the United States Department of the Interior, Bureau of Land Management or by a decree of a Court of Law and/or that the corner points mentioned in lines 3, 4 and 5 above were in conformance with the rules of the Michigan Board of Land Surveyors or by a Decree of a Court of Law; established, re-established, monumented, re-monumented, recovered, found as expressed below:

NOTE: Not more than 4 corners, all in the same town and range, may be recorded on this certificate.

	A	B	C	D	E	F	G	H	I	J	K	L	M
2	6	5	4	3	2	1							
3													
4	7	8	9	10	11	12							
5													
6	18	17	16	15	14	13							
7													
8	19	20	21	22	23	24							
9													
10	30	29	28	27	26	25							
11													
12	31	32	33	34	35	36							
13													

A. Description of original monument and accessories and/or subsequent restoration:

A-11 CORNER COMMON TO SEC'S. 30 & 31 T32N, R5W & SEC'S. 25 & 36, T32N, R6W SURVEYED IN 1839 BY JOHN HODGSON - G.L.O SET SECTION POST BEECH 8" S69°W 18 LINKS (11.88') - BEECH 6" N18°W 22 LINKS (9.9') SURVEYED 1972 BY CARL F. ROSER, PS 12038 FOUND PK NAIL OVER 1"X 36" AXLE SHAFT IN CENTER OF N-S BLACKTOP COUNTY ROAD AND CENTER OF GRAVEL ROAD WEST. FENCE TO EAST IS 24' NORTH. 20" W.PINE N55°W 91.40' - P.POLE S70°W 83.06' - P.POLE N27°E 118.47' SET CEDAR POST DUE E. 325' (LIBER 2, PAGE 47)


B. Description of corner evidence found and/or method applied in restoring or reestablishing corner:

A-11 CORNER COMMON TO SEC'S. 30 & 31 T32N, R5W & SEC'S. 25 & 36, T32N, R6W FOUND 1-1/4" IRON CENTER LINE OF Korthase AND ROGER ROADS.

Charlevoix Co. Surveyor  
APPROVED  
Signature *George J. Avendt, Jr.*  
Date: *Dec. 8, 1994*  
P.A. 345 - 1990

C. Description of monument for corner and accessories established to perpetuate locating the position of the corner:

A-11 CORNER COMMON TO SEC'S. 30 & 31 T32N, R5W & SEC'S. 25 & 36, T32N, R6W FOUND 1-1/4" IRON, REPLACED WITH CHARLEVOIX COUNTY MARKER.  
N47°E 60.01' 11" W.PINE/CAP # 16034  
S89°E 31.75' 6" DNR CEDAR POST  
S32°E 101.11' NW COR HOUSE  
S80°W 86.78' CROSS ON CONCRETE ELEC. TRANSFORMER PAD  
N15°W 110.11' P.POLE/CAP # 16034

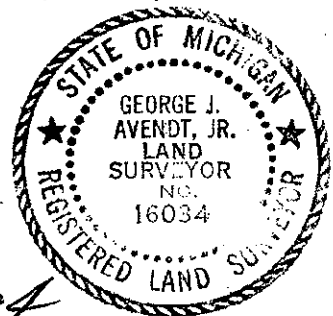

Signed by *George J. Avendt, Jr.* Date *8 Dec 1994*  
Surveyor's Michigan License No. 16034