

SURVEY & REMONUMENTATION

32-32-5 STATE OF MICHIGAN
COUNTY OF CHARLEVOIX
RECEIVED FOR RECORD

96 SEP 27 PM 3:23

OCT 18 1996 LAND CORNER RECORDATION CERTIFICATE
Filing Requirement of Act 74, Mich. P.A. 1970

Charles M. Bushkin
REGISTER OF DEEDS

For corners in
CHARLEVOIX
(County)

COMMISSION
Located In: _____ Corner Code # _____

1. Public Land Survey
T 32 R 5 D13
T _____ R _____
T _____ R _____
T _____ R _____

2. Property Controlling in Section
S _____ T _____ R _____
S _____ T _____ R _____

3. Miscellaneous Property in Sec.
S _____ T _____ R _____
S _____ T _____ R _____

Lot No. _____, Recorded Plat _____
Private Claims _____

Register of Deeds Stamp & File Number

ARTHUR R. RANGER, in a field survey on 05/04, 1996 do hereby state that under requirements of P.A. 74, Michigan P.A. of 1970, the corner points mentioned in lines 1 and 2 above were in conformance with regulations and rules therefore as required in the current manual of survey instructions of the United States Department of the Interior, Bureau of Land Management or by a decree of a Court of Law and/or that the corner points mentioned in lines 3, 4 and 5 above were in conformance with the rules of the Michigan Board of Land Surveyors or by a Decree of a Court of Law; established, re-established, monumented, discovered, found as expressed below:

NOTE: Not more than 2 corners, all in the same town and range, may be recorded on this certificate.

	A	B	C	D	E	F	G	H	I	J	K	L	M
1													
2	6		5		4		3		2		1		
3													
4	7		8		9		10		11		12		
5													
6	18		17		16		15		14		13		
7													
8	19		20		21		22		23		24		
9													
10	30		29		28		27		26		25		
11													
12	31		32		33		34		35		36		
13													

Description of original monument and accessories and/or subsequent restoration:

D-13 John Mullet set a Qr. Sec. post and witnessed: 1840

Witnesses:
Sugar 10" N73 W 38 lks.
Beech 10" N73 E 20 lks.

1971- Carl Roser, Surveyor reestablished by SP, per standard BLM instructions. He set a DNR monument and witnessed: 8" Maple S82 W 18.7'; 9" Maple S14 E 10.7'; 10" Maple N25 W 37.5'; See LCRC - Liber 1, pg. 65


Description of corner evidence found and/or method applied in restoring or reestablishing corner:

D-13
1996- Arthur R. Ranger, Surveyor found the DNR monument by Roser, and witnessed. The bearing on the Township line, and the distances between the corners to the East and West seemed reasonable.

Description of monument for corner and accessories established to perpetuate locating the position of the corner:

D-13 Found a DNR monument
9" Maple S14 E 10.87'
10" Maple S87 W 18.90'
12" Maple N64 W 9.48'
10" Maple N66 E 9.82'

Charlevoix Co. Surveyor
APPROVED
Signature *May C. Fenoldt*
Date: July 25, 1996

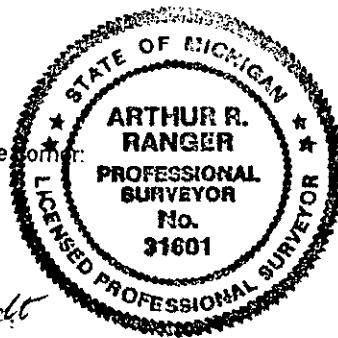

The corner found was accepted as a careful and faithful reestablishment off the position of the original corner.

Recorded by *Arthur R. Ranger*
Surveyor's Michigan License No. 31601

Date 05/24/96