

SEP 27 PM 3:26

SURVEY & REMONUMENTATION LAND CORNER RECORDATION CERTIFICATE
Filing Requirement of Act 74, Mich. P.A. 1970

For corners in OCT 18 1996

CHARLEVOIX
(County)

Located In:

Corner Code #

1. Public Land Survey

T 32NR 5W

F-13

T	R	_____	
T	R	_____	
T	R	_____	
T	R	_____	
S	T	R	_____
S	T	R	_____
S	T	R	_____
S	T	R	_____

2. Property Controlling In Section

3. Miscellaneous Property in Sec.

Charles M. ...
REGISTER OF DEEDS

Register of Deeds Stamp & File Number

4. Lot No. _____, Recorded Plat _____
5. Private Claims _____

ARTHUR R. RANGER, in a field survey on 05/04, 19 96 do hereby state that under requirements of P.A. 74, Michigan P.A. of 1970, the corner points mentioned in lines 1 and 2 above were in conformance with regulations and rules therefore as required in the current manual of survey instructions of the United States Department of the Interior, Bureau of Land Management or by a decree of a Court of Law and for all the corner points mentioned in lines 3, 4 and 5 above were in conformance with the rules of the Michigan Board of Land Surveyors or by a Decree of a Court of Law; established, re-established, monumented, covered, found as expressed below:

NOTE: Not more than 2 corners, all in the same town and range, may be recorded on this certificate.

	A	B	C	D	E	F	G	H	I	J	K	L	M
1													
2	6			5			4			3			2
3													
4	7			8			9			10			11
5													
6	18			17			16			15			14
7													
8	19			20			21			22			23
9													
10	30			29			28			27			26
11													
12	31			32			33			34			35
13													

Description of original monument and accessories and/or subsequent restoration:

- F-13
1840- John Mullet set the Qr. Sec. post and witnessed:
Sugar 10" N44 E 41 lks.
Beech 8" N58 W 8 lks.
- 1971- Carl Roser, surveyor reestablished by SP, per standard BLM instructions.
He witnessed- setting a DNR monument: 10" Maple S8 W 35.0'; 7" Ironwood S83 W 48.0'; P.P. (highline) N31 W 80.45'. See LCRC liber 1, pg. 64. Also refer to the DNR survey.


Description of corner evidence found and/or method applied in restoring or reestablishing corner:

F-13 Arthur R. Ranger, surveyor found the DNR monument. The corner falls on the southerly side of an electric transmission line clearing. The clearing runs NWLY. The bearing and distances on the township line East and West seem reasonable.

Description of monument for corner and accessories established to perpetuate locating the position of the corner:

- 13 Found a DNR monument
12" Maple S11 E 35.45'
12" Maple S44 W 25.91'
18" Beech N64 W 65.87'
9" Maple N43 E 78.85'

Charlevoix Co. Surveyor
APPROVED
Signature: *Mary C. Feindel*
Date: *July 25, 1996*

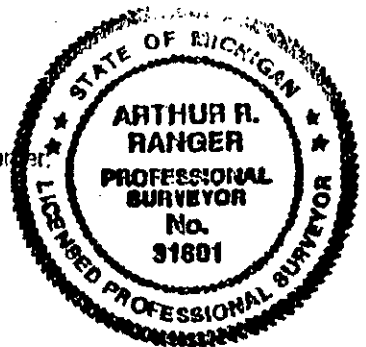

The DNR monument found was accepted as a careful and faithful reestablishment of the position of the original corner.

Recorded by *Arthur R. Ranger*
Surveyor's Michigan License No. 31601

Date 05/24/96