

SEP 1 2 1995

LIBER 002 PAGE 380

STATE OF MICHIGAN COUNTY OF CHARLEVOIX RECEIVED FOR RECORD

95 JUN 29 AM 10:13

COMMISSION

LAND CORNER RECORDATION CERTIFICATE Filing Requirement of Act 74, Mich. P.A. 1970

Charles M. Barber REGISTER OF DEEDS

For corners in Charlevoix (County)

Located In: Corner Code #

- 1. Public Land Survey T 32N R 5W J-13
2. Property Controlling in Section S T R
3. Miscellaneous Property in Sec. S T R
4. Lot No. , Recorded Plat
5. Private Claims

Register of Deeds Stamp & File Number

Grid table with columns A-M and rows 2-13. Contains numbers 1-36 in a grid pattern.

I, Arthur R. Ranger, in a field survey on Nov. 05, 1994, do hereby certify that under requirements of P.A. 74, Michigan P.A. of 1970, the corner points mentioned in lines 1 and 2 above were in conformance with regulations and rules therefore as required in the current manual of survey instructions of the United States Department of the Interior, Bureau of Land Management or by a decree of a Court of Law and/or that the corner points mentioned in lines 3, 4 and 5 above were in conformance with the rules of the Michigan Board of Land Surveyors or by a Decree of a Court of Law; established, re-established, monumented, re-monumented, recovered, found as expressed below:

NOTE: Not more than 4 corners, all in the same town and range, may be recorded on this certificate.

A. Description of original monument and accessories and/or subsequent restoration:

- 1840- John Mullet, Surveyor set Qr. Section post and witnessed: Sugar 12" N40°W 36lks; Sugar 12" N52°E 18lks.
1903- E. A. Robinson, Surveyor found old stake, set new stake an iron rod 1-1/4"x30" with small stones around; Old notes said that Mr. Hetrick would set a F.E. post 50 links East and West of corner. Witnesses: Sugar 12" N36.5°W 36lks; Sugar 12" N60°E 18lks.
1946- George Blass, Surveyor (M.S:H.D.) found and used an old axel shaft for the corner in his survey.
1970- Carl Roser, Surveyor found axel shaft as recovered by M.S.H.D. (George Blass) in

B. Description of corner evidence found and/or method applied in restoring or reestablishing corner: * See reverse side


1994- Found 1/2" iron pipe over axel shaft with small stones around; Found old F.E. post 33.0' West and fence line; Found Roser ties. The corner falls in the center of the old Mackinaw Trail rd. grade now abandoned. Corner was accepted, and a 4" Dia. Harrison monument was set over the top of the axel shaft.

APPROVED
Mary C. Fernett
Date: June 16, 1995
PA 345 of 1990

C. Description of monument for corner and accessories established to perpetuate locating the position of the corner:

J-13 Set a 4" Dia. Harrison over the axel shaft
Witness:
P.P. N10°W 141.30'
Hwy. R/W mon. West 32.85'
P.P. S18°W 172.76'
Hwy. U.S.-131 East 98.61'

Found 1/2" iron pipe as recorded in L.1, Pg. 68, Charlevoix County, MI, and is accepted as a careful and faithful perpetuation of the position of the original corner.

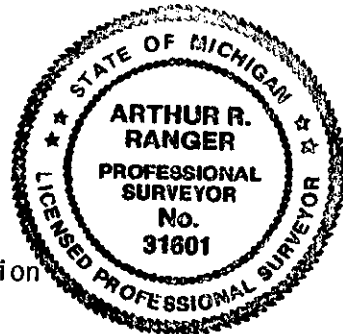

Signed by [Signature] Date 01/26/95

Surveyor's Michigan License No. 31601

~~1/2" iron pipe~~

A. continued

November 1946. Corner also noted in old County Surveyor notes at the Charlevoix County Register of Deeds, Book C-302. Witnesses: Found 1/2" iron pipe over axel shaft; 14" Apple N68°W 56.21'; P.P. N15°W 141.2'; Ctr. U.S.-131 East 98.95'.

Char. Abs. & Eng.