

**LAND CORNER RECORDATION CERTIFICATE**  
**Filing Requirement of Act 74, Mich. P.A. 1970**

For corners in

<u>Charlevoix</u> (County)	Located In:	Corner Code #
1. Public Land Survey	T <u>32N</u> R <u>5W</u>	<u>L-11</u>
	T _____ R _____	
2. Property Controlling in Section	S <u>25</u> T <u>32N</u> R <u>5W</u>	<u>15</u>
	S _____ T _____ R _____	
3. Miscellaneous Property in Sec.	S _____ T _____ R _____	
	S _____ T _____ R _____	

**Register of Deeds Stamp & File Num**

4. Lot No. \_\_\_\_\_, Recorded Plat \_\_\_\_\_

5. Private Claims \_\_\_\_\_

I, Carl T. Kiiskila, in a field survey on Feb. 24, 19 98 do hereby state that under requirements of P.A. 74, Michigan P.A. of 1970, the corner points mentioned in lines 1 and 2 above were in conformance with regulations and rules therefore as required in the current manual of survey instructions of the United States Department of the Interior, Bureau of Land Management or by a decree of a Court of Law and /or that the corner points mentioned in lines 3, 4 and 5 above were in conformance with the rules of the Michigan Board of Land Surveyors or by a Decree of a Court of Law; established, re-established, monumented, recovered, found as expressed below:

A	B	C	D	E	F	G	H	I	J	K	L	M
1												
2	6		5		4		3		2		1	
3												
4	7		8		9		10		11		12	
5												
6	18		17		16		15		14		13	
7												
8	19		20		21		22		23		24	
9												
10	30		29		28		27		26		25	
11												
12	31		32		33		34		35		36	
13												

**NOTE: Not more than 2 corners, all in the same town and range, may be recorded on this certificate.**

**A. Description of original monument and accessories and/or subsequent restoration:**

- |   |   |
|---|---|
| L-11 GLO set section post - William Burt, 1850.<br>Wit: Beech 6" N 38° E 18 links<br>Beech 12" S 45° W 22 links | 15 - This position was not established during the original government survey. |
|---|---|


**B. Description of corner evidence found and/or method applied in restoring or reestablishing corner:**

- |  |   |
|--|---|
| L-11 Reestablished the quarter corner common to Section 25 and Section 36 by single proportionate measurement midway and online between section corners. | 15 - Established the Southwest corner of the Southeast quarter of the Southwest quarter of Section 25 per standard BLM instructions for subdivision of a section. |
|--|---|

**C. Description of monument for corner and accessories established to perpetuate locating the position of the corner:**

- |  |   |
|--|---|
| L-11 Set standard DNR monument and carsonite marker post.<br>Wit: Set nail in 8" Yellow Birch West 29.87'<br>Set nail in 5" Maple S 25° W 26.54'<br>Set nail in 7" Maple S 81° E 29.52'<br>Set nail in 4" Maple N 15° W 28.35' | 15 - Set 5/8" x 32" rerod with cap and carsonite marker post.<br>Wit: Set nail in 14" Basswood S 37° W 19.03'<br>Set nail in 14" Beech N 71° W 28.57'<br>Set nail in 12" Basswood N 10° W 20.66'<br>Set nail in 12" Basswood S 48° E 19.09' |
|--|---|

Signed by Carl T Kiiskila  
 Surveyor's Michigan License No. 33981

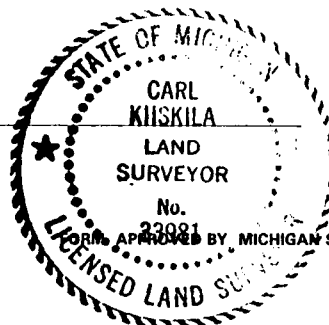

Date 7-26-99