


LAND CORNER RECORDATION CERTIFICATE
Filing Requirement of Act 74, Mich. P.A. 1970

For corners in

<u>Charlevoix</u> (County)	Located In:	Corner Code #
1. Public Land Survey	T <u>32N</u> R <u>5W</u>	<u>K-10</u>
	T <u>32N</u> R <u>5W</u>	<u>K-11</u>
2. Property Controlling in Section	S _____ T _____ R _____	_____
	S _____ T _____ R _____	_____
3. Miscellaneous Property in Sec.	S _____ T _____ R _____	_____
	S _____ T _____ R _____	_____

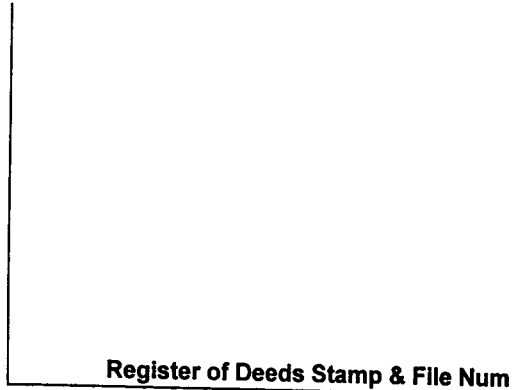

4. Lot No. _____, Recorded Plat _____

5. Private Claims _____

I, Carl T. Kiiskila, in a field survey on Feb. 24, 19 98 do hereby state that under requirements of P.A. 74, Michigan P.A. of 1970, the corner points mentioned in lines 1 and 2 above were in conformance with regulations and rules therefore as required in the current manual of survey instructions of the United States Department of the Interior, Bureau of Land Management or by a decree of a Court of Law and /or that the corner points mentioned in lines 3, 4 and 5 above were in conformance with the rules of the Michigan Board of Land Surveyors or by a Decree of a Court of Law; established, re-established, monumented, recovered, found as expressed below:

1	A	B	C	D	E	F	G	H	I	J	K	L	M
2		6		5		4		3		2		1	
3													
4		7		8		9		10		11		12	
5													
6		18		17		16		15		14		13	
7													
8		19		20		21		22		23		24	
9													
10		30		29		28		27		26		25	
11													
12		31		32		33		34		35		36	
13													

NOTE: Not more than 2 corners, all in the same town and range, may be recorded on this certificate.

A. Description of original monument and accessories and/or subsequent restoration:

K-10 GLO set section post - William Burt, 1850.
 Wit: Cedar 10" N 18° E 16 links
 B. Ash 8" S 20° W 12 links

K-11 GLO set section post - William Burt, 1850.
 Wit: Hemlock 6" N 21° W 26 links
 Cedar 15" S 27° E 25 links

B. Description of corner evidence found and/or method applied in restoring or reestablishing corner:

K-10 Reestablished the quarter corner common to Section 25 and Section 26 at the center of a good east-west farm lane and a fence line north. This position fits occupation in Section 26 and old witnesses indicate the approximate location was used by other surveyors.

K-11 Reestablished the Northwest corner of Section 36 by double proportionate measurement between corners one mile to the south and east and corners one half mile to the north and west.


C. Description of monument for corner and accessories established to perpetuate locating the position of the corner:

K-10 Set 5/8" x 32" rerod with cap.
 Wit: * 3" Cedar S 13° E 16.20'
 * 4" Balsam S 67° W 29.21'
 Set nail in 4" Cedar N 30° W 20.12'
 * 8" dead Larch N 9° E 25.86'
 * 3" & 5" twin Cedar 19.25'
 Carsonite marker post North 25' ±

K-11 Set standard DNR monument and carsonite marker post.
 Wit: Set nail in 8" Ash S 25° W 24.06'
 Set nail in 10" Cedar N 67° W 29.57'
 Set nail in 12" Cedar N 28° E 22.12'
 Set nail in 4" Maple S 88° E 19.91'

* (old witness by others)

Signed by Carl T. Kiiskila
 Surveyor's Michigan License No. 33981

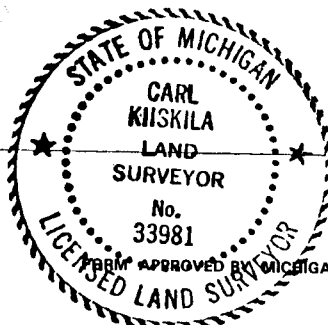

Date 7-26-99