

LAND CORNER RECORDATION CERTIFICATE
Filing Requirement of Act 74, Mich. P.A. 1970

For corners in

<u>Charlevoix</u> (County)	Located In:	Corner Code #
1. Public Land Survey	T <u>32N</u> R <u>5W</u>	<u>K-7</u>
	T <u>32N</u> R <u>5W</u>	<u>L-7</u>
2. Property Controlling in Section	S _____ T _____ R _____	_____
	S _____ T _____ R _____	_____
3. Miscellaneous Property in Sec.	S _____ T _____ R _____	_____
	S _____ T _____ R _____	_____

Register of Deeds Stamp & File Num

4. Lot No. _____, Recorded Plat _____

5. Private Claims _____

I, Carl T. Kiiskila, in a field survey on Feb. 10, 19 98 do hereby state that under requirements of P.A. 74, Michigan P.A. of 1970, the corner points mentioned in lines 1 and 2 above were in conformance with regulations and rules therefore as required in the current manual of survey instructions of the United States Department of the Interior, Bureau of Land Management or by a decree of a Court of Law and /or that the corner points mentioned in lines 3, 4 and 5 above were in conformance with the rules of the Michigan Board of Land Surveyors or by a Decree of a Court of Law; established, re-established, monumented, recovered, found as expressed below:

A	B	C	D	E	F	G	H	I	J	K	L	M
1												
2	6		5		4		3		2		1	
3												
4	7		8		9		10		11		12	
5												
6	18		17		16		15		14		13	
7												
8	19		20		21		22		23		24	
9												
10	30		29		28		27		26		25	
11												
12	31		32		33		34		35		36	
13												

NOTE: Not more than 2 corners, all in the same town and range, may be recorded on this certificate.

A. Description of original monument and accessories and/or subsequent restoration:

K-7	GLO set section post - William Burt, 1850. Wit: Cedar 12" N 50° W 8 links Lynn 10" S 29° E 16 links	L-7	GLO set section post - William Burt, 1850. Wit: Hemlock 24" N 28° E 15 links Beech 5" South 5 links
	E.K. Robinson, Dec. 1888, on page 32 of County Survey notes recorded new bearing trees: Sugar 12" S 27½° W 26 links Y. Birch 18" N 85° E 19 links		In 1891, page 72 through 79 of County Survey notes, a full break of Section 13 was done. No name was given for the surveyor.


B. Description of corner evidence found and/or method applied in restoring or reestablishing corner:

K-7	Found a hollowed out 21" Yellow Birch tree believed to be E.K. Robinson's N.B.T. Set a DNR monument at the recorded bearing and distance.	L-7	Reestablished the South quarter corner of Section 13 online between the section corners to the east and west and on a good north-south fence line. This position seems to fit the occupation in Section 13.
-----	---	-----	---

C. Description of monument for corner and accessories established to perpetuate locating the position of the corner:

K-7	Set standard DNR monument and carsonite marker post. Wit: Set nail in 12" Cedar N 51° W 23.47' Set nail in 7" Cedar N 11° E 27.29' Set nail in 21" Yellow Birch N 85° E 12.52' Set nail in 5" Cedar S 9° W 22.34'	L-7	Set standard DNR monument and carsonite marker post. Wit: Set nail in 14" Black Cherry N 23° W 303.34' Set nail in 5" Ash S 72° W 127.87' Set nail in 9" Cedar clump S 18° W 156.31' Set nail in 11" Apple S 19° E 263.05'
-----	---	-----	--

Signed by Carl T. Kiiskila
 Surveyor's Michigan License No. 33981

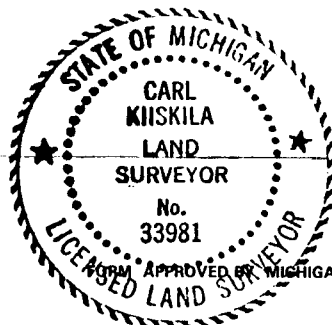

Date 7-26-99