

LAND CORNER RECORDATION CERTIFICATE
Filing Requirement of Act 74, Mich. P.A. 1970


For corners in

<u>Charlevoix</u> (County)	Located In:	Corner Code #
1. Public Land Survey	T <u>32N</u> R <u>5W</u>	<u>I-7</u>
	T <u>32N</u> R <u>5W</u>	<u>J-7</u>
2. Property Controlling in Section	S _____ T _____ R _____	_____
	S _____ T _____ R _____	_____
3. Miscellaneous Property in Sec.	S _____ T _____ R _____	_____
	S _____ T _____ R _____	_____

4. Lot No. _____, Recorded Plat _____

5. Private Claims _____

I, Carl T. Kiiskila, in a field survey on Apr. 15, 19 98 do hereby state that under requirements of P.A. 74, Michigan P.A. of 1970, the corner points mentioned in lines 1 and 2 above were in conformance with regulations and rules therefore as required in the current manual of survey instructions of the United States Department of the Interior, Bureau of Land Management or by a decree of a Court of Law and /or that the corner points mentioned in lines 3, 4 and 5 above were in conformance with the rules of the Michigan Board of Land Surveyors or by a Decree of a Court of Law; established, re-established, monumented, recovered, found as expressed below:

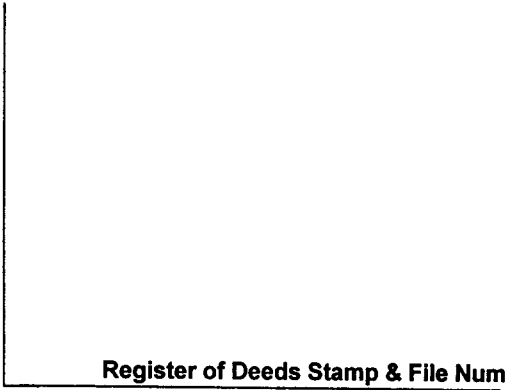

	A	B	C	D	E	F	G	H	I	J	K	L	M
1													
2		6		5		4		3		2		1	
3													
4		7		8		9		10		11		12	
5													
6		18		17		16		15		14		13	
7									●	●			
8		19		20		21		22		23		24	
9													
10		30		29		28		27		26		25	
11													
12		31		32		33		34		35		36	
13													

NOTE: Not more than 2 corners, all in the same town and range, may be recorded on this certificate.

A. Description of original monument and accessories and/or subsequent restoration:

I-7 GLO set section post - William Burt, 1850.
 Wit: Sugar 15" S 75° W 26 links
 Sugar 18" N 56° E 45 links

J-7 GLO set section post - William Burt, 1850.
 Wit: Beech 10" N 65° W 19 links
 Beech 8" S 62° E 36 links

John E. Ferguson, RLS #24595 in May 1980 set a Charlevoix County marker.
 Wit: 8" Maple N 40° W 21.10'
 8" Maple N 10° E 33.63'
 6" Maple S 40° W 19.30'
 6" Maple S 15° E 21.75'

E.A. Robinson, Dec. 1914 used this corner while setting the center of Section 23. No new witnesses were recorded.

B. Description of corner evidence found and/or method applied in restoring or reestablishing corner:

I-7 Found a Charlevoix County monument. All witnesses were gone due to power line construction.


J-7 Set a standard DNR monument at an old fence corner. This position fits well with E.A. Robinson's work done in Section 23.

C. Description of monument for corner and accessories established to perpetuate locating the position of the corner:

I-7 Found Charlevoix County monument near the southerly edge of an east-west gravel road.
 Wit: Power pole S 4° E 31.95'
 Set nail in 5" Basswood S 75° W 38.73'
 Capped iron #24595 N 5° E 33.03'
 Power pole N 42° E 39.59'
 Set nail in 5" Basswood N 10° W 36.27'

J-7 Set standard DNR monument.
 Wit: Set nail in 28" Maple S 20° W 6.87'
 Set nail in 7" Maple N 80° W 11.50'
 Set nail in 7" Maple S 83° E 19.94'
 Set nail in 12" Maple N 18° E 19.23'

Signed by Carl T. Kiiskila
 Surveyor's Michigan License No. 33981

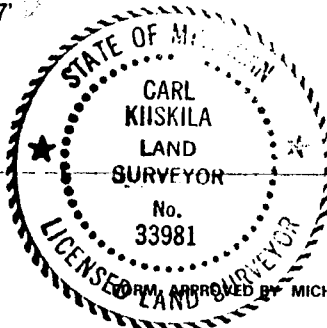

Date 7-26-99