

THIS IS BEING RERECORDED TO CORRECT THE COUNTY

STATE OF MICHIGAN
COUNTY OF CHARLEVOIX
RECEIVED FOR RECORD

96 DEC 11 PM 2:58

Mary C. Feendt 2/13/97

LAND CORNER RECORDATION CERTIFICATE
Filing Requirement of Act 74, Mich. P.A. 1970

Charles M. Bosser
REGISTER OF DEEDS

For corners in
Charlevoix & Antrim
(County)

Located In: Corner Code #

1. Public Land Survey	T 32N	R 7W	A-1
	T 33N	R 7W	A-13
	T 32N	R 8W	M-1
	T 33N	R 8W	M-13
2. Property Controlling in Section	S	T	R
3. Miscellaneous Property in Sec.	S	T	R

RECEIVED FOR RERECORDING
DATE Feb. 13, 1997 at 11:00 A.M.

Charles M. Bosser
Register of Deeds-Charlevoix Co., MI

Register of Deeds Stamp & File Number

- 4. Lot No. _____, Recorded Plat _____
- 5. Private Claims _____

I, Wayne E. Boss, in a field survey on OCTOBER 22, 19 96, do hereby certify that under requirements of P.A. 74, Michigan P.A. of 1970, the corner points mentioned in lines 1 and 2 above were in conformance with regulations and rules therefore as required in the current manual of survey instructions of the United States Department of the Interior, Bureau of Land Management or by a decree of a Court of Law and/or that the corner points mentioned in lines 3, 4 and 5 above were in conformance with the rules of the Michigan Board of Land Surveyors or by a Decree of a Court of Law; established, re-established, monumented, re-monumented, recovered, found as expressed below:

A	B	C	D	E	F	G	H	I	J	K	L	M
2	6	5	4	3	2	1						
3												
4	7	8	9	10	11	12						
5												
6	18	17	16	15	14	13						
7												
8	19	20	21	22	23	24						
9												
10	30	29	28	27	26	25						
11												
12	31	32	33	34	35	36						
13												

NOTE: Not more than 4 corners, all in the same town and range, may be recorded on this certificate.

A. Description of original monument and accessories and/or subsequent restoration:

A-1 GLO JUNE 1839 WILLIAM MILLER OCT. 1883 3/4" PIPE SET BY UNKNOWN
 JOHN HODGSON FOUND TOWN COR. USED BY JOHN FERGUSON IN
 SET POST AT INTERSECTION NO NEW WIT. 1978 SURVEY. LCRC L.2 PG. 95
 CORNER TOWNSHIPS 32 & 33 3. 8" BASS N29W 30.5'
 NORTH OF RANGES 7 & 8 WEST 4. 4" POPLAR N39E 24.25'
 1. HEMLOCK 16 N82E 19 5. 14" POLAR 5.42E 58.28'
 2. HEMLOCK 12 N11W 28 6. 6" PINE S45W 70.71'

B. Description of corner evidence found and/or method applied in restoring or reestablishing corner:

A-1 3/4" PIPE FOUND ON A FENCE LINE TO THE NORTH.
 3. 12" BASSWOOD N29W 30.48'
 4. 10" POPLAR N39E 23.67'
 5. 12" POPLAR S35E 57.52'
 6. 8" PINE S45W 70.35'

GLO TO B-1 2712.6' MEAS. 2679.67'
 TO A-2 3024.12' MEAS. 3012.05'
 TO L-13 T32N-R8W 2640' MEAS. 2636.12'
 TO M-12 T32N-R8W 2640' MEAS. 2666.12'


SURVEY &
REMONUMENTATION
MAR 21 1997
COMMISSION

Charlevoix Co. Surveyor
APPROVED
Signature Mary C. Feendt
Date: Nov. 13, 1996

C. Description of monument for corner and accessories established to perpetuate locating the position of the corner:

A-1 & A-13 & M-1 & M-13 A-1 T32N-R7W TOWNSHIP CORNER COMMON CORNER A-13 T33N-R7W M-1 T32N-R8W, M-13 T33N-R8W.
 CHARLEVOIX COUNTY MON SET.
 3. 12" BASSWOOD N29W 30.48'
 4. 10" POPLAR N39E 23.67'
 5. 12" POPLAR S35E 57.52'
 6. 8" PINE S45W 70.35'

LIBER 003 PAGE 95

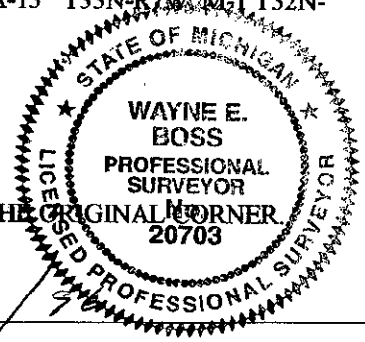

AND IS ACCEPTED AS THE BEST AVAILABLE EVIDENCE OF THE POSITION OF THE ORIGINAL CORNER.

Signed by Wayne E. Boss Date 11/29/96
Surveyor's Michigan License No. 20703 LIBER 003 PAGE 73