

**SURVEY & REMONUMENTATION**

JAN 26 1998

**SECTION**

**LAND CORNER RECORDATION CERTIFICATE**  
Filing Requirement of Act 74, Mich. P.A. 1970

STATE OF MICHIGAN  
COUNTY OF CHARLEVOIX  
RECEIVED FOR RECORD

97 DEC 15 PM 2:38

*Charles M. Cook*  
REGISTER OF DEEDS

For corners in

Charlevoix (County)	Located In:	Corner Code #
1. Public Land Survey	T <u>22N</u> R <u>7W</u> SURVEY & <u>A-2</u>	
	T <u>22N</u> R <u>8W</u> _____	M-2
2. Property Controlling in Section	S _____ T _____ R _____	
3. Miscellaneous Property in Sec.	S _____ T _____ R _____	

Register of Deeds Stamp & File Number

4. Lot No. \_\_\_\_\_, Recorded Plat \_\_\_\_\_  
5. Private Claims \_\_\_\_\_

I, Wayne E. Boss, in a field survey on May, 1997 do hereby state that under requirements of P.A. 74, Michigan P.A. of 1970, the corner points mentioned in lines 1 and 2 above were in conformance with regulations and rules therefore as required in the current manual of survey instructions of the United States Department of the Interior, Bureau of Land Management or by a decree of a Court of Law and /or that the corner points mentioned in lines 3, 4 and 5 above were in conformance with the rules of the Michigan Board of Land Surveyors or by a Decree of a Court of Law; established, re-established, monumented, recovered, found as expressed below:

**NOTE:** Not more than 2 corners, all in the same town and range, may be recorded on this certificate.

	A	B	C	D	E	F	G	H	I	J	K	L	M
1													
2	6		5		4		3		2		1		
3													
4	7		8		9		10		11		12		
5													
6	18		17		16		15		14		13		
7													
8	19		20		21		22		23		24		
9													
10	30		29		28		27		26		25		
11													
12	31		32		33		34		35		36		
13													

**A. Description of original monument and accessories and/or subsequent restoration:**

A-2	GLO OCT. 1856	NOV. 1983	FEB. 1991
	E.D. ATWATER	N.B. DEYOUNG	ART LENNOX
	SET SUGAR POST 2 1/2 IN	FD 2" PIPE ORIGIN UNKNOWN	FD 2" PIPE
	1. BEECH 10" N58E 8 LKS	3. 1/4" IR ROD E 33'	3. 1/2" IR E 33.0'
	2. BEECH 11" S39 1/2 W 52 LKS	4. 5" ASH S15W 59.31'	7. FENCE POST E 31.0'
		5. ELM STUMP S40E 37.6'	8. 4" CHERRY S45W 31.0'

**B. Description of corner evidence found and/or method applied in restoring or reestablishing corner:**


A-2 FD 2 1/2 " PIPE. NO WITS FD

A-2 TO A-1	GLO 3032.04'	MEAS. 3012.05
A-2 TO A-3	GLO 2640.0'	MEAS. 2635.99

Charlevoix Co. Surveyor  
**APPROVED**  
Signature Wayne E. Boss  
Date: 12-23-97

**C. Description of monument for corner and accessories established to perpetuate locating the position of the corner:**

A-2 2 1/2" PIPE REPLACED WITH STEEL CHARLEVOIX COUNTY MARKER.  
9. SIGN POST N60W 50.05'  
10. 10" CHERRY S50W 35.45 SET NAIL & TAG  
11. ST. SIGN POST S25W 25.62  
12. GATE POST S80E 31.96 SET NAIL & TAG  
MAY 1997, WAYNE E BOSS  
AND IS ACCEPTED AS A CAREFUL & FAITHFUL REESTABLISHMENT OF THE POSITION OF THE ORIGINAL CORNER.

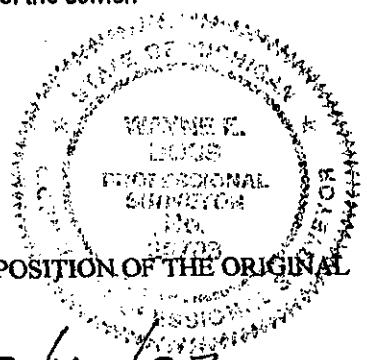

Signed by Wayne E. Boss Date 12/23/97  
Surveyor's Michigan License No. 20703