

**SURVEY & REMONUMENTATION**

JAN 26 1998

**SECTION**

**LAND CORNER RECORDATION CERTIFICATE**  
Filing Requirement of Act 74, Mich. P.A. 1970

STATE OF MICHIGAN  
COUNTY OF CHARLEVOIX  
RECEIVED FOR RECORD

97 DEC 15 PM 2:39

*Charles M. Coakley*  
REGISTER OF DEEDS

For corners in

Charlevoix  
(County)

Located In:

Corner Code #

1. Public Land Survey	<u>72N</u> R <u>7W</u>	<u>A-3</u>
	T R	
	<u>72N</u> R <u>8W</u>	<u>M-3</u>
	T R	
2. Property Controlling in Section	S T R	
	S T R	
3. Miscellaneous Property in Sec.	S T R	
	S T R	

Register of Deeds Stamp & File Number

4. Lot No. \_\_\_\_\_, Recorded Plat \_\_\_\_\_  
5. Private Claims \_\_\_\_\_

Wayne E. Boss, in a field survey on May, 19 do hereby state that under requirements of P.A. 74, Michigan P.A. of 1970, the corner points mentioned in lines 1 and 2 above were in conformance with regulations and rules therefore as required in the current manual of survey instructions of the United States Department of the Interior, Bureau of Land Management or by a decree of a Court of Law and for that the corner points mentioned in lines 3, 4 and 5 above were in conformance with the rules of the Michigan Board of Land Surveyors or by a Decree of a Court of Law; established, re-established, monumented, recovered, found as expressed below:

NOTE: Not more than 2 corners, all in the same town and range, may be recorded on this certificate.

A	B	C	D	E	F	G	H	I	J	K	L	M
1												
2	6	5	4	3	2	1						
3												
4	7	8	9	10	11	12						
5												
6	18	17	16	15	14	13						
7												
8	19	20	21	22	23	24						
9												
10	30	29	28	27	26	25						
11												
12	31	32	33	34	35	36						
13												

A. Description of original monument and accessories and/or subsequent restoration:

- |                              |                             |                             |
|------------------------------|-----------------------------|-----------------------------|
| A-3 GLO OCT. 1856            | OCT. 1883                   | OCT. 2, 1991                |
| E.D. ATWATER                 | WM. MILLER, DEPUTY SURVEYOR | NICHOLAS B. DEYOUNG         |
| SET HEMLOCK POST 4"          | FD. POST NO WITNESSES       | FD 1/2" IR ORGIN UNKNOWN    |
| 1. HEMLOCK 12" N81/2W 6LKS   |                             | 3. 8" WHITE PINE N70W 64.0' |
| 2. HEMLOCK 12" S401/2W 18LKS |                             | 4.. 10" MAPLE N8W 30.0'     |
|                              |                             | 5. 8" CEDAR S65W 56.72'     |

B. Description of corner evidence found and/or method applied in restoring or reestablishing corner:


- A-3 FOUND 3/4" BAR  
10' NORTH OF ROAD TO EAST & 12' EAST OF SLOUGH ROAD  
4. 12" MAPLE N8W 28.99

A-3 TO A-4 GLO 2640 MEASURES 2635.94'

Charlevoix Co. Surveyor  
**APPROVED**  
Signature Mary C. Ferrell  
Date: 12-23-97

C. Description of monument for corner and accessories established to perpetuate locating the position of the corner:

- A-3 3/4" BAR REPLACED WITH CHARLEVOIX COUNTY MONUMENT  
4. 12" MAPLE N8W 28.99'  
7. 6" CEDAR N57E 14.66'  
8. 8" POPLAR N65W 33.46'  
9. 14" POPLAR S43W 60.99'  
10. STREET SIGN POST S25E 48.77'

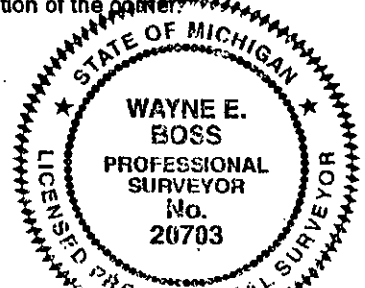

AND IS ACCEPTED AS A CAREFUL & FAITHFUL REESTABLISHMENT OF THE POSITION OF THE ORIGINAL CORNER.

Signed by Wayne E. Boss  
Surveyor's Michigan License No. 20703

Date 12/12/97