SURVEY & REMONUMENTATION

JAN 2 6 1998

SECTION

STATE OF MICHIGAN
COUNTY OF CHARLEVOIX
RECEIVED FOR RECORD

97 DEC 15 PM 2:40

Charlene M. Chaddie
REGISTER OF DEEDS

Register of Deeds Stamp & File Number

LAND CORNER RECORDATION CERTIFICATE
Filing Requirement of Act 74, Mich. P.A. 1970

For corners in Charlevoix (County)

	Located In:	Corner Code #
1. Public Land Survey	T32N R 7W	A-4
	T___ R___	
	T32N R 8W	M-4
	T___ R___	
2. Property Controlling in Section	S___ T___ R___	
	S___ T___ R___	
3. Miscellaneous Property in Sec.	S___ T___ R___	
	S___ T___ R___	

4. Lot No. _____, Recorded Plat _____
5. Private Claims _____

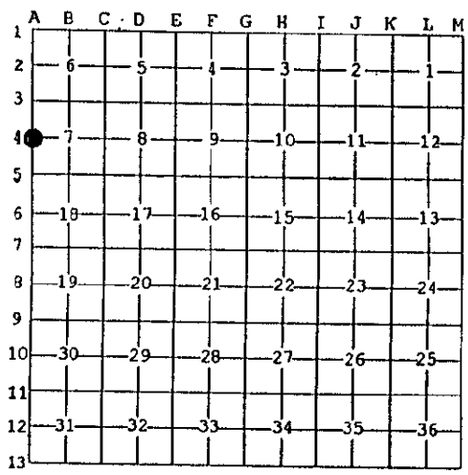

I, Wayne E. Boss, in a field survey on May 97, 19___ do hereby state that under requirements of P.A. 74, Michigan P.A. of 1970, the corner points mentioned in lines 1 and 2 above were in conformance with regulations and rules therefore as required in the current manual of survey instructions of the United States Department of the Interior, Bureau of Land Management or by a decree of a Court of Law and /or that the corner points mentioned in lines 3, 4 and 5 above were in conformance with the rules of the Michigan Board of Land Surveyors or by a Decree of a Court of Law; established, re-established, monumented, recovered, found as expressed below:

NOTE: Not more than 2 corners, all in the same town and range, may be recorded on this certificate.

A. Description of original monument and accessories and/or subsequent restoration:

A-4 GLO OCT. 1856
E.D. ATWATER
SET BEECH POST 3"
1. SUGAR 12" N53E 21 LKS
2. HEMLOCK 18" S66 1/2W 36LKS

APRIL 15, 1978
BERYL M. JONES
FD. 1/2" IR. IN ROAD
3. POWER POLE S86E 37.7'
4. POWER POLE N75W 35.25'

LENNOX & ASSOCIATES
FD. 1/2" IR
3. POWER POLE S86W 37.70'
4. POWER POLE N75W 35.25

MAY 13, 1996 JOHN E. FERGUSON, FOUND 1" BAR, 3. PWR POLE S86E 37.43', 4. PWR POLE N79W 35.36., 5. SW COR. HSE N59E 127.46', 6. NW COR. GARAGE S74E 67.64'

B. Description of corner evidence found and/or method applied in restoring or reestablishing corner:

A-4 MAY 1997
FOUND RAILROAD SPIKE
3. POWER POLE S86E 37.43'
4. POWER POLE N79W 35.36'
5.. SW COR OF HOUSE N59E 127.46'
6. NW COR OF GARAGE S74E 67.64'

Charlevoix Co. Surveyor
APPROVED
Signature Mary C. Feindt
Date: 10-23-97

C. Description of monument for corner and accessories established to perpetuate locating the position of the corner:

A-4 RAILROAD SPIKE REPLACED WITH STEEL CHARLEVOIX COUNTY MARKER
3. POWER POLE S86E 37.43'
4. POWER POLE N79W 35.36'
5. SW COR OF HOUSE N59E 127.46'
6. NW COR OF GARAGE S74E 67.64'
A-4 T0 A-5 GLO 2640.0' MEASURE 2647.18'
AND IS ACCEPTED AS A CAREFUL & FAITHFUL REESTABLISHMENT OF THE POSITION OF THE ORIGINAL CORNER

STATE OF MICHIGAN
WAYNE E. BOSS
PROFESSIONAL SURVEYOR
No. 20703
LICENSED PROFESSIONAL SURVEYOR

Signed by _____ Date 12/12/97
Surveyor's Michigan License No. 20703

LIBER 003 PAGE 123

FORM APPROVED BY MICHIGAN STATE BOARD OF PROFESSIONAL SURVEYORS, JAN. 26, 1971
REVISED MAY 14,1975
REVISED JAN. 1983