

JAN 26 1998

SECTION

LAND CORNER RECORDATION CERTIFICATE
Filing Requirement of Act 74, Mich. P.A. 1970

STATE OF MICHIGAN
COUNTY OF CHARLEVOIX
RECEIVED FOR RECORD

97 DEC 15 PM 2:42

Charlene M. Boaler
REGISTER OF DEEDS

For corners in

Charlevoix
(County)

Located In:

Corner Code #

1. Public Land Survey

T 32N R 7W

A-6

T R

T 32N R 8W

M-6

T R

2. Property Controlling
in Section

S T R

S T R

3. Miscellaneous
Property in Sec.

S T R

S T R

Register of Deeds Stamp & File Number

4. Lot No. _____, Recorded Plat _____
5. Private Claims _____

Wayne E. Boss

May 97

in a field survey on _____, 19____ do hereby state that under requirements of P.A. 74, Michigan P.A. of 1970, the corner points mentioned in lines 1 and 2 above were in conformance with regulations and rules therefore as required in the current manual of survey instructions of the United States Department of the Interior, Bureau of Land Management or by a decree of a Court of Law and/or that the corner points mentioned in lines 3, 4 and 5 above were in conformance with the rules of the Michigan Board of Land Surveyors or by a Decree of a Court of Law; established, re-established, monumented, recovered, found as expressed below:

NOTE: Not more than 2 corners, all in the same town and range, may be recorded on this certificate.

	A	B	C	D	E	F	G	H	I	J	K	L	M
1													
2		6		5		4		3		2		1	
3													
4		7		8		9		10		11		12	
5													
6		10		17		16		15		14		13	
7													
8		19		20		21		22		23		24	
9													
10		30		29		28		27		26		25	
11													
12		31		32		33		34		35		36	
13													

A. Description of original monument and accessories and/or subsequent restoration:

A-6 OCT. 1856

E.D. ATWATER, DEPUTY SURVEYOR
SET SUGAR POST 3 INCH
1. BEECH 5" N57W 11 LKS
2. BEECH 5" S70 1/2E 9 LKS

FEB. 1972

MARY C. FEINDT
FOUND IRON
NO WITNESSES

JULY 1980

SHERMAN A. CHAMBERLAIN
FOUND SPIKE AT FENCE INTERSECTION
REPLACED WITH 3/4" PIPE
3. 20" MAPLE NORTH 14.69'
4. 10" MAPLE N75E 9.18'
5. 5" MAPLE S10E 6.11'
6. 6" MAPLE S75W 17.73'

B. Description of corner evidence found and/or method applied in restoring or reestablishing corner:

A-6 MAY 1997


FOUND 3/4" PIPE AT FENCE INTERSECTION TO NORTH, SOUTH & WEST
3. 20" MAPLE NORTH 14.67'
4. 10" MAPLE N75E 9.13'
5. 5" MAPLE S10E 6.13'
6. 6" MAPLE S75W 17.69'

Charlevoix Co. Surveyor
APPROVED
Signature *Mary C. Feindt*
Date: 12-23-97

C. Description of monument for corner and accessories established to perpetuate locating the position of the corner:

A-6 3/4" PIPE REPLACED WITH STEEL CHARLEVOIX COUNTY MARKER
3. 26" MAPLE NORTH 14.69 SET NEW SPIKE & TAG
4. 14" MAPLE N75E 9.13' SET NEW SPIKE & TAG
5. 5" MAPLE S10E 6.13 SET NEW SPIKE & TAG
6. 6" MAPLE S75W 17.69' SET NEW SPIKE & TAG

AND IS ACCEPTED AS A CAREFUL & FAITHFUL REESTABLISHMENT OF THE POSITION OF THE ORIGINAL CORNER

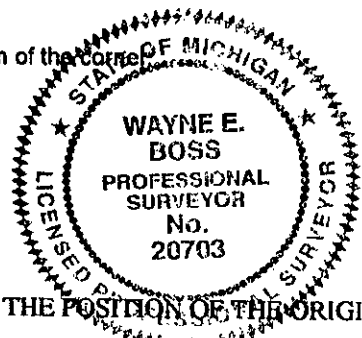

Signed by *Wayne E. Boss*
Surveyor's Michigan License No. 20703

Date 12/12/97