

SURVEY & REMONUMENTATION

JAN 26 1998

STATE OF MICHIGAN
COUNTY OF CHARLEVOIX
RECEIVED FOR RECORD

97 DEC 15 PM 2:46

SECTION

LAND CORNER RECORDATION CERTIFICATE
Filing Requirement of Act 74, Mich. P.A. 1970

Charles M. Boss
REGISTER OF DEEDS

For corners in

Charlevoix

Located in:

Corner Code #

(County)

1. Public Land Survey

T 32N R 7W

A-8

T R

T 32N R 8W

M-8

T R

2. Property Controlling in Section

S T R

S T R

3. Miscellaneous Property in Sec.

S T R

S T R

Register of Deeds Stamp & File Number

4. Lot No. _____, Recorded Plat _____

5. Private Claims _____

Wayne E. Boss

May 97

I, _____, in a field survey on _____, 19____ do hereby state that under requirements of P.A. 74, Michigan P.A. of 1970, the corner points mentioned in lines 1 and 2 above were in conformance with regulations and rules therefore as required in the current manual of survey instructions of the United States Department of the Interior, Bureau of Land Management or by a decree of a Court of Law and/or that the corner points mentioned in lines 3, 4 and 5 above were in conformance with the rules of the Michigan Board of Land Surveyors or by a Decree of a Court of Law; established, re-established, monumented, recovered, found as expressed below:

NOTE: Not more than 2 corners, all in the same town and range, may be recorded on this certificate.

	A	B	C	D	E	F	G	H	I	J	K	L	M
1													
2	6			5			4			3			2
3													
4	7			8			9			10			11
5													
6	18			17			16			15			14
7													
8	19			20			21			22			23
9													
10	30			29			28			27			26
11													
12	31			32			33			34			35
13													

A. Description of original monument and accessories and/or subsequent restoration:

A-8 OCTOBER 1856

E.D. ATWATER, DEPUTY, SURVEYOR
SET BEECH POST 2 1/2 INCH

1. BEECH 10 INCH N69W 10 LKS
2. BEECH 10 INCH S46E 210 LKS

OCTOBER 12, 1976

BERYL M. JONES
FOUND PIPE

3. FENCE CORNER POST S82W 27.4'
4. POWER POLE S8W 31.0'

Li. 002, Pg. 33.

B. Description of corner evidence found and/or method applied in restoring or reestablishing corner:

A-8 MAY 1997

FOUND 3/4 INCH BAR

5. 24" MAPLE N10W 5.65'
6. 4" MAPLE N70E 4.73'
7. 7.8" MAPLE S30E 13.62
8. 10" MAPLE S50W 15.60'


Charlevoix Co. Surveyor
APPROVED
Signature *Mary L. Felsold*
Date: 12/23/97

C. Description of monument for corner and accessories established to perpetuate locating the position of the corner:

A-8 3/4 INCH BAR REPLACED WITH STEEL CHARLEVOIX COUNTY MARKER

5. 24" MAPLE N10W 5.65' SET SPIKE & TAG OVER OLD WITNESSES
6. 4" MAPLE N70E 4.73' SET SPIKE & TAG OVER OLD WITNESSES
7. 8" MAPLE S30E 13.62' SET NAIL & TAG OVER OLD WITNESSES
8. 10" MAPLE S50W 15.60' SET NAIL & TAG OVER OLD WITNESSES

AND IS ACCEPTED AS ACAREFUL & FAITHFUL REESTABLISHMENT OF THE THE POSITION OF THE ORIGINAL CORNER

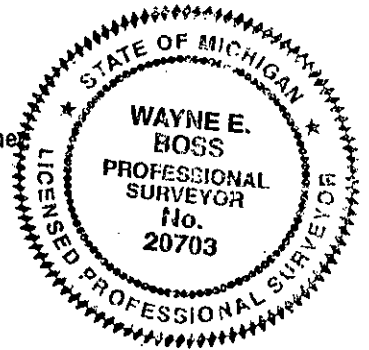

Signed by _____
Surveyor's Michigan License No. 20703

Date: 12/12/97